

Trego

KANSAS

12


21W

Section 26 Township _____ Range _____

Well No. #1 Schoenthaler (Schoenthaler)

Company Prime Drlg. & Davis Bros.

NORTH

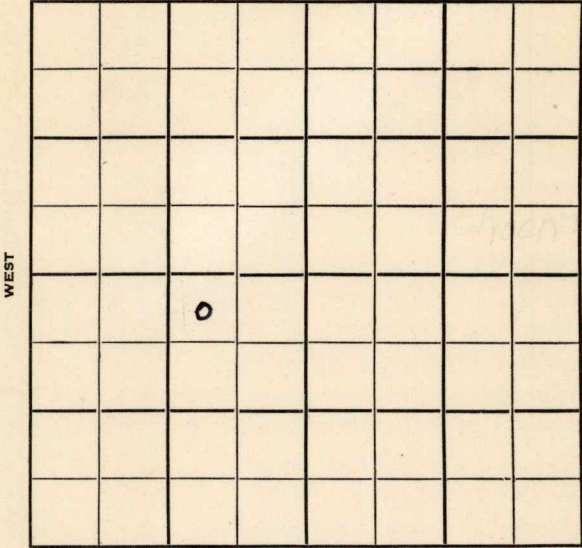

SOUTH

Trego

KANSAS

Sec. 26 Twp. 12 R. 21W

Well No. #1 Schoenthaler Farm

Prime Drlg. & Davis Bros. Company


Prime Drlg. Contractor

330 Ft. from N. Line

_____ Ft. from S. Line

990 Ft. from E. Line

_____ Ft. from W. Line

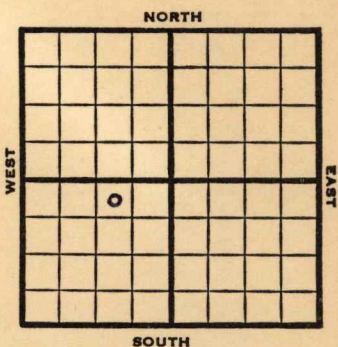

NW NE SW
Stanolind Farmout

1952 Elev. 2231' REPORT

11/19 Spud 11-13-52
8" @ 195
Drlg. 2945'

LL/27 Lans 3514
DST 3504-62, 1 hr., 100' O&GCM
120' hly o&gcm 1270#
DST 3678-3725, 1 hr., 1362' gas,
145' hly ocm 290#
Arb 3906'
RTD 3910
5" @ 3905'

12/4 NR

12/11 DD 3914 SO 3910-B

12/18 500A S/8 BFPH 2% wtr Plug 3730 S/8 BFPH
45/3202-10 1000A S/1 1/2 BOPH 2000A S/3
BOPH PB 3565 36/3550-56 30 GOPH /
5 GW 500A S/14 BOPH / 1 BWPB PB 3540
/3511-29 1000A Wtr Sq.

12/25 " " " "

1/1 NR
1/8 NR

OVER

#1 Schoenthaler

1953
1/23

Spud 11-13-52

Oil Well

TD 3914

8" @ 195

Lans 3514

DST 3504-62, opn 1 hr., rec.

100' O&GCM, 120' HO&GCM, 1270#

DST 3678-3725, opn 1 hr., rec.

1362' gas, 145' hocm, 290#

Arb. 3906

TD 3910, 5" @ 3908

DD 3914, SØ 3910-13, 500A

S/18 bfph 20% wtr.

S/18 bfph 35% wtr.

SP 3730, 45/3702-10, 1000A

S/1 $\frac{1}{4}$ boph 2000A, S/3 boph

PB 3565, 36/3550-56, 30 goph

5 gw 500A

S14 boph 1 bw PB 3540

Perf 3511-29, 1000A 2000A

wtr CO to 3730

Comp. 211 bopd 26% wtr.

COMPLETED

