

Trego

KANSAS

Section 26 Township 12 Range 21 W

Well No. # 4 Schoenthaler

Company Texas Company

NORTH

0							

WEST

EAST

SOUTH

Trego

KANSAS

Sec. 26 Twp. 12 R. 21W

Well No. #4 Schoenthaler Farm

Texas Co. Company

Noble Drlg. Contractor


 Ft. from N. Line

330 Ft. from S. Line

 Ft. from E. Line

330 Ft. from W. Line

SW SW NW

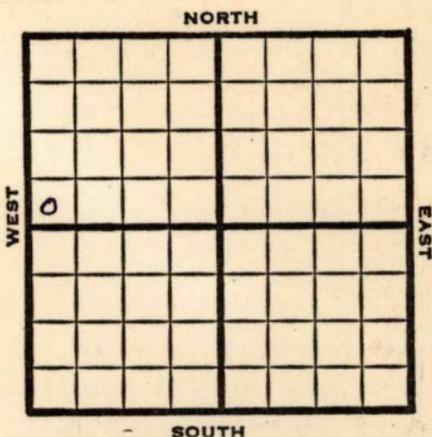

1952

Elev. 2221'

REPORT

3/19

Spud 3-11-52
8" @ 499'

3/25

Drlg. 3677'

Heeb. 3466

Lans. 3499

Arb. 3877

RTD 38900

5" @ 3884' WOC

4/1

DP DD to 3895 S/ 10 gal oph for
24hrs. 1000 A S/ 20 gal wtr. ph
DD to 3901 S/ 12 gal oph & 12
gal w ph DD 3906 TD fill up
2500 wtr. PB 3880

4/9

13/3876-80, 20 gal wph DP to 3835
PB 3824 19/ 3695-3201 500 A
16 BF 3 hrs. w/ 6 boph for 3 hrs.
3000 A test 14 boph 15 hrs. next four
hrs. avg. 6.4 boph PB 3688
36/377-87 S/ 10 boph 3000 A
S/ 7 boph DP to 3688 CO to 3824
S/ 9 boph thru all perms. POP

4/23

Spud 3-11-52 Oil Well TD 3906'
8" @ 499' Heeb. 3466 Lans. 3499
Arb. 3877' TD 3890 5" @ 3884
DD 3895 S/ 10 goph 1000 A
S/ 20 goph DD 3901 S/ 12 goph
12 gw DD 3906 FU 2500' wtr.
PB 3880 13/ 3876-80 20 gwph

OVER

1952.

4/23

DP to 3835 PB 3824
19/ 3695-3701 500 A 16 bf 3 hr.
S/ 6 boph 3 hr. 3000 A 14 boph
PB 3688 36/ 3677-87 S/ 10 goph
3000 A S/ 7 boph DP to 3688
CO to 3824 S/ 9 boph
Comp. 323 bopd

COMPLETED

County Trego State Kansas

Sec. 26 (Blk. 12 (Sur. 21W (Rge.) Map No.

Operator Texas Company

Well No. 4 Farm Schoenthaler

Elev. 2221 Location SW SW NW

COMPLETE

330 Ft. From S Line NW
330 Ft. From W Line Quarter

1st. Report

Completion APR 23 1952

Remarks

Noble Drlg. - Contr.

Spudding Date 3-11-52

Drlg. Data Oil well TD3906

8" @ 499 Heeb. 3466 Lans. 3499

Arb. 3877 TD 3890 5" @ 3884

DD 3895 S/ 10 goph 1000 A S/ 20 goph

DD 3901 S/ 12 goph 12 gw DD 3906

FU 2500' water PB 3880 13/ 3876-80

20 gwph DP to 3835 PB 3824

19/ 3695-3701 500 A 16 bf 3 hr.

S/ 6 boph 3 hr. 3000 A 14 beph

PB 3688 36/ 3677-87 S/ 10 goph 3000 A

S/ 7 boph DP to 3688 CO to 3824

S/ 9 boph Comp. 323 bopd