

Woodson

KANSAS

Sec. 2 Twp. 24 R. 13E

Well No. #1 Dehlinger Farm

Earl Sauder et al Company

Sauder Contractor


_____ Ft. from N. Line

330 Ft. from S. Line

1200 Ft. from E. Line

_____ Ft. from W. Line

SW SE SW

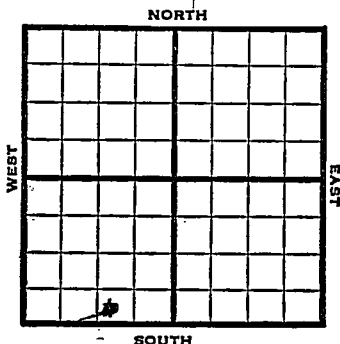

1952

REPORT

3/12

Cable tools MI

5/13

Spud 4-7-52

D&A TD 1728'

10" @ 670 8" @ 835' 6" @ 1323'

Miss. 1696 Miss. Li 1712

TD 1728' D&A

ABANDONED

