


Woodson

Form 51-5M-10-26-Mid-West

Map No. KANS Sec. 2 Twp. 24 R. 13-E

Well No. 1-Dye Farm
Sullivan & Mehole Company

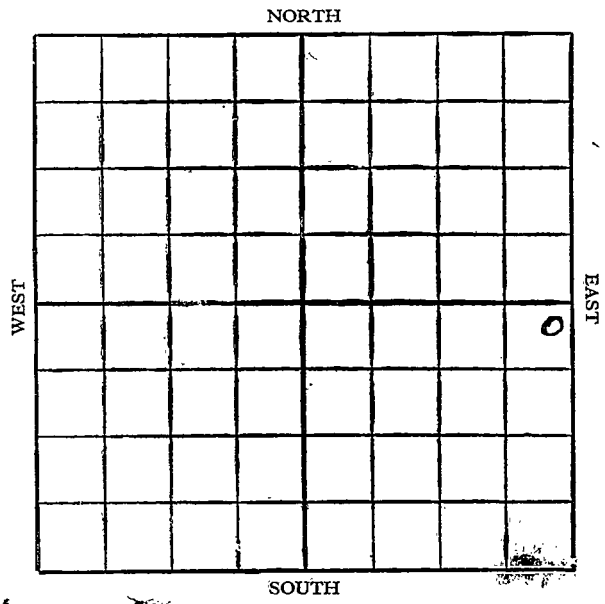

Location

Drilling Remarks

.....

.....

RECORD

Cased..... in. ft.

Sand

Gas

Oil

Total Depth.....

Rig Up.....

Drilling Remarks

.....

.....

PRODUCTION

1st 24 hrs. Nat.....

1st 24 hrs. after shot.....

Gas..... cu. ft.

Dry Hole.....

Abandoned.....

Map No. _____ Sec. 2 Twp. 24 R. 13E

Well No. 1 - Dye Farm _____


Sullivan & Melrose Company

250 Ft. from N. Line

_____ Ft. from S. Line

250 Ft. from E. Line

_____ Ft. from W. Line

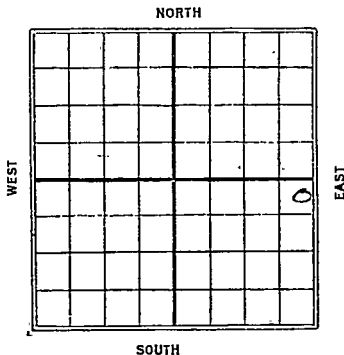

1927

Date	REPORT
1/26	Location
2/3	same
2/10	—
2/17	—
2/24	—
3/2	—
3/9	Spudding
3/16	—
3/24	fishing 440
3/30	—
4/7	—
4/13	—
4/20	—
4/27	Dredg 1220
5/5	Sand 1651-85 - H.F.W.
	top line 1747 - H.F.W.
	1800-1807 T.D. Shut down
5/11	D. & A. 1807 ± T.D.

Woodson

~~OK~~ KANSAS

Map No. _____ Sec. *2* Twp. *24* R. *13*

Well No. _____
Dye
Sullivan & Melrode Company

Contractor

FIRST REPORTS

SECTION PLAT

250 Ft. from N. Line
_____ Ft. from S. Line
250 Ft. from E. Line
_____ Ft. from W. Line

			0

Location _____
Rig up _____
Drilling and Remarks:

RECORD

Cased _____ in., _____ ft.
Sand _____
Gas _____
Oil _____
Total Depth _____

PRODUCTION

1st 24 hrs. Nat. _____
1st 24 hrs. after shot _____
Gas _____ Cu. Ft.
Dry Hole _____
Abandoned _____

Returned
Card
1927

Date *1927*
JAN 26 1927

CHAS. L. SHERWOOD

192 _____ Scout

Woodson

no map
KANSAS

Map No. _____ Sec. *2* Twp. *24* R. *13*

Well No. *1 Super*

Sullivan & McRose Company

Contractor

COMPLETED

SECTION PLAT

750 Ft. from N. Line

_____ Ft. from S. Line

250 Ft. from E. Line

_____ Ft. from W. Line

ABANDONED

			o

Location _____

Rig up _____

Drilling and Remarks:

Bore 1651-85 New

Top line 1747 New

1807

RECORD

Cased _____ in., _____ ft.

Sand _____

Gas _____

Oil _____

Total Depth *1807*

PRODUCTION

1st 24 hrs. Nat. _____

1st 24 hrs. after shot _____

Gas _____ Cu. Ft.

Dry Hole

Abandoned

Date

MAY 1 1927

CHAS. L. SHERWOOD

Check Location First Report

Shows NENESE

ADVISE

THANKS

SAM

CASE NO

Returned.....

Cards *mm*.....

Tracing *None*.....

France Map.....

Scarborough Map *[Signature]*.....

Moody Map.....

Scarborough Plat Book.....

Moody Plat Book.....

form