

Sec. 26 Twp. 12 R. 21W

Well No. #5 Schoenthaler Farm

Texas Company

Contractor

Ridgeway


Ft. from N. Line

990 Ft. from S. Line

330 Ft. from E. Line

Ft. from W. Line

NE SE NW

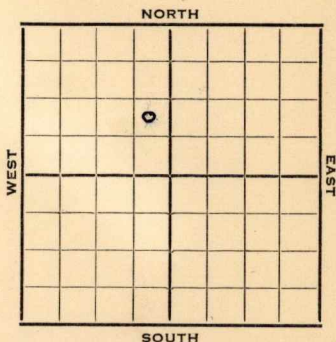

1952 Elev. 2241' REPORT

4/9 Spud 2-6-52
8" @ 538'
Drlg. 915'

4/23 **Topeka 3264'** **Heeb 3495'** **Lans. 3530'**
DST 3550-80, 1½ hrs, 55' M 1130#
DST 3682-3720, 1 hr, 30' M 90#
Arb. 3921'
DST 3897-3915', 1½ hrs, 30' OCM, 30' M 210#
DST 3918-25, 1 hr, 25' SOCM, 65#
DST 3924-30, 1 hr, 235' oil, 910#
TD 3930' 5" @ 3922' WOCT

4/30 DP CO to 3930 S/3 BOPH for 2 hrs.
S/2½ BOPH & trace POP

5/7 NR

5/14 NR

5/21 "

5/28 "

6/11 Spud 4-6-52
Oil well TD 3930' 8" @ 538
Top. 3264' **Heeb 3495'** **Lans. 3530'**
DST 3550-80 open 1½ hr. rec 55' mud
DST 3682-3720 open 1 hr, rec 30' mud
Arb. 3921'

OVER

1952

6/11

(Information continued)

DST 3897-3915 open 1 $\frac{1}{2}$ hr, rec 30' OCM
30' mud

DST 3918-25 open 1 hr. rec 25' SOCM

DST 3924-30 open 1 hr. rec 235' oil

TD 3930' 5" @ 3922 CO to TD

S/3 BOPH 2 hr. S/2 $\frac{1}{2}$ BOPH

Comp. 190 BOPD

COMPLETED

County **Trego** State **Kansas**

Sec. **26** (Blk. Twp.) **12** (Sur. Rge.) **21W** Map No.

Operator **Texas**

Well No. **5** Farm **Schoenthaler**

Elev. Location **NE SE NW**

		0			

FIRST REPORT

990 Ft. From **S** Line **NW**

330 Ft. From **E** Line Quarter

Ist. Report **APR 9 1952**

Completion

Remarks

Spudding Date **4-6-52**

Drlg. Data **Ridgeway**

8" @ 538 Drlg. 915

J. G. MCGEHEE