

KANSAS

FORM 51 5M 4-41 PETROL


Butler

Section 33 Township 25 Range 5-E

Well No. 96 Stokes

Company Cities Service Oil

NORTH Eldorado pool

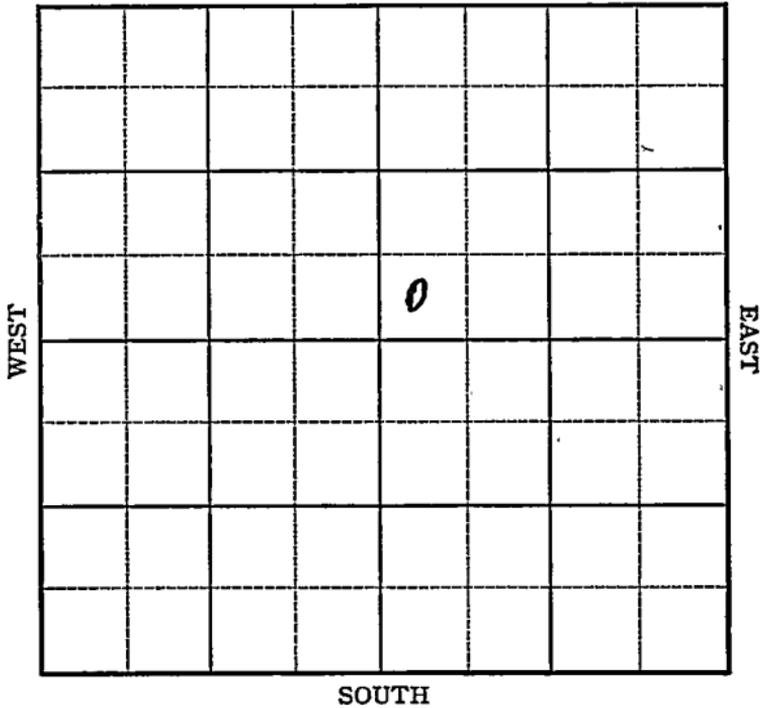

Sec. 33 Twp. 25 R. 5-E

Well No. #96 Stoker Farm

Cities Service Oil Company


(Eldorado)

_____ Ft. from N. Line

330 Ft. from S. Line

_____ Ft. from E. Line

330 Ft. from W. Line

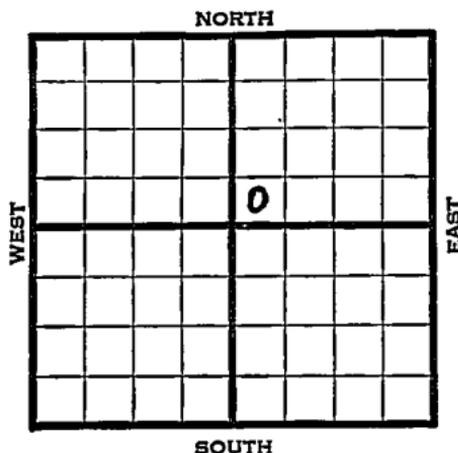

1947	REPORT			
10/15	Drlg. 950'			
10/23	K.C. 1945'	T.D. 1959'		
	6" - 1952'	RUST.		
10/30	T.D. 1999'	2000 acid.		
11/6	" "	" "		
11/13	" "	" "		
11/20	" "	" "		
11/25	K.C. 1945'			
	6" - 1952'			
	T.D. 1999'			
	2000 acid.			
	Pump 13 oil & 74 water.			
	36. Gravity			
	COMPLETED			

Map No. K-14 Sec. 33 Twp. 25 R. 5EWell No. 96 StokerCities Service Oil Company**FIRST REPORT**

Contractor _____

SW NE

SECTION PLAT

_____ Ft. from N. Line

330 Ft. from S. Line

_____ Ft. from E. Line

330 Ft. from W. Line

ELDORADO POOL

Location _____

Rig up _____

Drilling and Remarks:

Drlg. 950'

RECORD

Cased _____ in., _____ ft.

Sand _____

Gas _____

Oil _____

Total Depth _____

PRODUCTION

1st 24 hrs. Nat. _____

1st 24 hrs. after shot _____

Gas _____ Cu. Ft.

Dry Hole _____

Abandoned _____

Date

OCT 15 1941

19

S. J. LEWIS Scout

