


Section 27
26 Township 12 Range 21W
 Well No. #1 Deutscher
 Company Texas

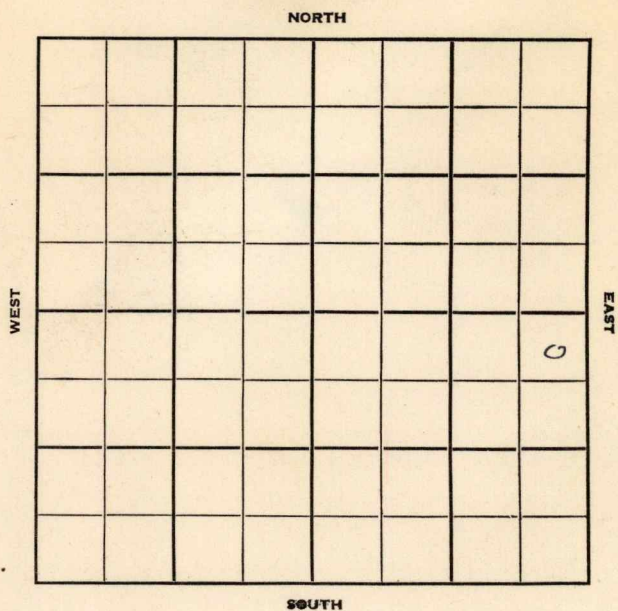

Trego

KANSAS ✓

Sec. 27 Twp. 12 R. 21W

Well No. #1 Deutscher Farm

Texas

Company

Noble

Contractor

Ridgeway

330 Ft. from N. Line


Ft. from S. Line

330

Ft. from E. Line

Ft. from W. Line

NE NE SE

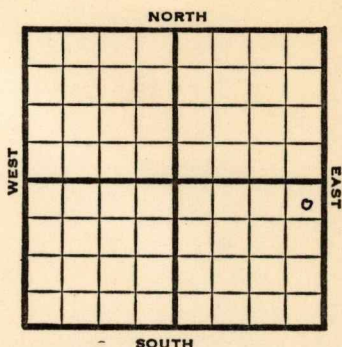

1952 Elev. 2229' REPORT

3/26 Spud 3-24-52
8" @ 560' WOC

4/1 Drlg. 3620'

4/9 Lans. 3512

DST 3682-3710, 1 hr. 5' m O#

DST 3821-76, 1 hr. 15' m

240# 5" @ 3906 WOC

4/23 Cong. 3844' Arb. 3885' TD 3906'
Perf. A. Testing

4/30 PB 3712 16/3667-72 NS 500A
S/3 BOPH POP

5/7 NR

5/14 NR

5/21 "

5/28 "

6/11 Spud 3-24-52
Oil well TD 3906' 8" @ 560
Anhy 1605'
DST 3537-60 open 1½ hr. rec 85' HO
& GCM, 60' water
Lans. 3512'
DST 3682-3710 open 1 hr, rec 5' mud
DST 3821-76 open 1 hr. rec 15' mud
5" @ 3906 Cong. 3844' Arb. 3885'
TD 3906 5" @ 3906 CC to 3904'

OVER

1952

6/11

(Information continued)

52/3886-3903 SSO 3500 A 5 GO

45 GWPH Sq off 3886-3903 CO to 3904

47/3883-3903 B/ $\frac{1}{2}$ GWPH 500 A

S/17 BWPH PB 3762 22/3725-32

500 A S/16 BOPH PB 3712

16/3667-72 500 A S/3 BOPH

Comp. 125 BOPD

COMPLETED

County **Trego** State **Kansas**
 Sec. **26** (Blk.) **12** (Sur.) **21W** Map No.

Operator **Texas**
 Well No. **1** Farm **Deutscher**

Elev. **2229** Location **NE NE SE**

FIRST REPORT

330 Ft. From **N** Line **SE**

330 Ft. From **E** Line Quarter

1st. Report **MAR 26 1952**

Completion

Remarks

Noble - Contr.

Spudding Date **3-24-52**

Drlg. Data **Ridgeway**

8" @ 560 W.O.C.

County Trego State Kansas
 Sec. 26 (Blk.) 12 (Sur.) 21W Map No.
 Operator Texas Company
 Well No. 1 Farm Deutscher
 Elev. 2229 Location NE NE SE



330 Ft. From N Line SE
 330 Ft. From E Line Quarter

1st. Report

Completion JUN 11 1952

Remarks Ridgeway Pool

Noble Drlg. - Contr.

Spudding Date 3-24-52

Drlg. Data Oil well TD 3906

8" @ 560 Anhy 1605 DST 3537-60

open 1½ hr. Rec. 85' ho & gcm 60' water

Lans. 3512 DST 3682-3710 open 1 hr.

Rec. 5' mud DST 3821-76 open 1 hr.

Rec. 15' mud 5" @ 3906 Cong. 3844

Arb. 3885 TD 3906 5" @ 3906

CO to 3904 52/ 3886-3903 SSO 3500 A

5 go 45 gwph sq off 3886-3903

CO to 3904 47/ 3883-3903 B/ ½ gwph

500 A S/ 17 bwph PB 3762 22/ 3725-32

500 A S/ 16 goph PB 3712 16/ 3667-72

500 A S/ 3 boph Comp. 125 bopd

J. G. McGEHEE

Kansas


Map No. _____ Sec. 27 Twp. 12 R. 21WWell No. 1 Deutscher_____
Texas Company _____ Company_____
CORRECTION _____ Contractor

NE NE SE

SECTION PLAT

330 _____
Ft. from N. Line_____
Ft. from S. Line330 _____
Ft. from E. Line_____
Ft. from W. Line

Trego County

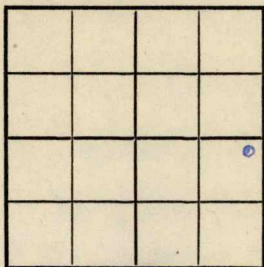

Location _____

Rig up _____

Drilling and Remarks:

Completed

6-11-52 in

26-12S-21W

RECORD

Cased _____ in., _____ ft.

Sand _____

Gas _____

Oil _____

Total Depth _____

PRODUCTION

1st 24 hrs. Nat. _____

1st 24 hrs. after shot _____

Gas _____ Cu. Ft.

Dry Hole _____

Abandoned _____

Date

JUL 23 1952

19

J. G. McGEHEE

Scout