

KANSAS

Section 27 Township 12 Range 21W

Well No. #1 E. King

Company Texas Co.

NORTH

							0

WEST

EAST

SOUTH

Sec. 27 Twp. 12 R. 21 W

Well No. # 1 E. King Farm

Texas Company Company

Noble Drlg. Contractor


Ft. from N. Line

330 Ft. from S. Line

330 Ft. from E. Line

Ft. from W. Line

SE SE NE

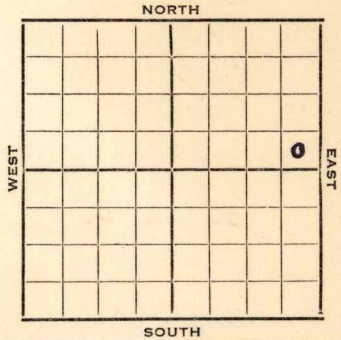

1952 *Ch 2233* REPORT

- 4/23 Set 8" @ 552  
Spur 4-21-52
- 4/30 Heeb. 3486  
Lans. 3519  
DST 3543-70 1 hr. 225 HGCM 60' VSOCM  
1200# DST 3663-80 1 hr. 900' gas  
150' VHOCM 1015#  
Drlg. 3692'
- 5/7 Arb. 3888  
DST 3924-36, 1 hr. 2616' wtr.  
1170# TD 3936' 5" @ 3936' WOCT
- 5/14 CO 3936' Fill up 1800' water.  
PB 3930' 19/3924-30 S/18 BWPB 250A  
Sq off CO 3906' 69/3883-3905  
S/2 BOPB
- 5/21 PB 3766 13/3713-19 NS 500 A  
S/8 BOPB PB 3708 31/3688-98 1  
galoph 500 A S/13 Bo 6 hrs 3000 A  
S/23 BO 7 hr. PB 3684 25/3674-82  
1½ galoph 500 A S/7 BOPB for 2 hrs.  
CO 3706 S/8.9 Boph
- 5/28 POP
- 6/11 NR
- 6/18 NR

LOVER

1952

6/25

Spud 4-21-52

Oil Well TD 3936 8" @ 552

Heeb. 3486

Lans. 3519

DST 3543-70 open 1 hr. rec. 225' hgcm  
60 bsocm

DST 3663-80 open 1 hr. rec. 900' gas  
150' whocm Arb. 3888

DST 3924-36 open 1 hr. rec. 2616' wtr.

TD 3936 5" @ 3936 FU 1800' wtr.

PB 3930 19/ 3924-30 S/ 18 bwph

250 A CO to 3906 69/ 3883-3905

S/ 2 boph PB 3766 13/ 3713-19

500 A S/ 8 boph PB 3708 31/ 3688-98

1 goph 500 A S/ 13 bo 6 hr.

3000 A S. 23 bo 7 hr. PB 3684

25/ 3674-82 1½ goph 500 A S/ 7 boph

CO to 3706 S/ 8.9 boph

Comp. 231 bopd 4% wtr.

**COMPLETED**

County Trego State Kansas

Sec. 27 (Blk.) 12 (Sur.) 21W Map No.

Operator Texas Company

Well No. 1 Farm E. King

Elev. Location SE SE NE


330 Ft. From S Line NE

330 Ft. From E Line Quarter

Ist. Report APR 23 1952

Completion

Remarks

Noble Drlg. - Contr.

Spudding Date 4-21-52

Drlg. Data

set 8"

D.H. Don

