


Section 27 Township 12 Range 21 W

Well No. # 2 L. Deutscher

Company Texas Company

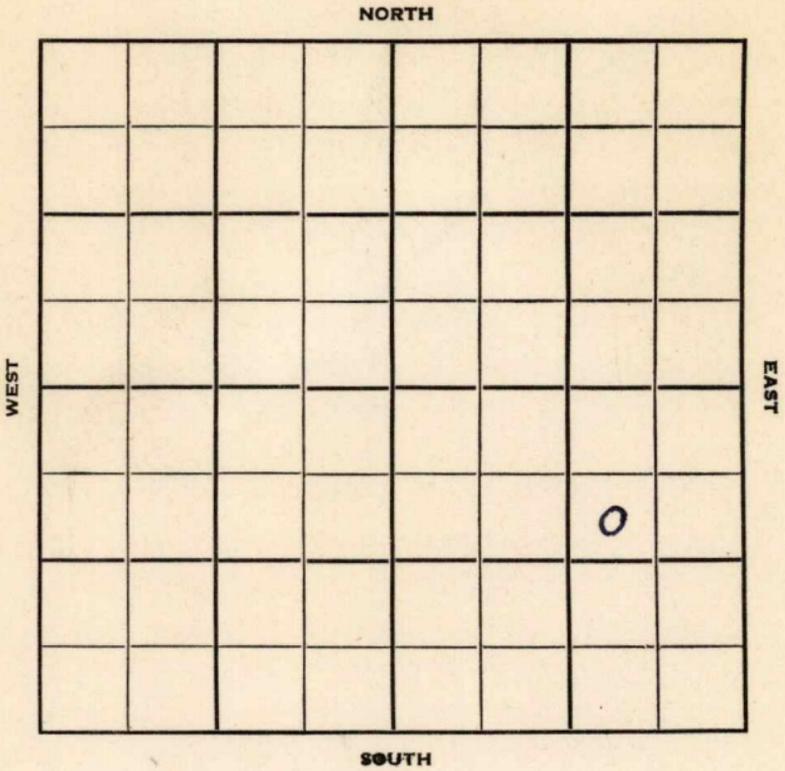



Sec. 27 Twp. 12 R. 21 W

Well No. # 2 L. Deutscher Farm

Texas Company Company

Contractor

**Ridgeway Pool**


990 Ft. from N. Line

..... Ft. from S. Line

990 Ft. from E. Line

..... Ft. from W. Line

SW NE SE

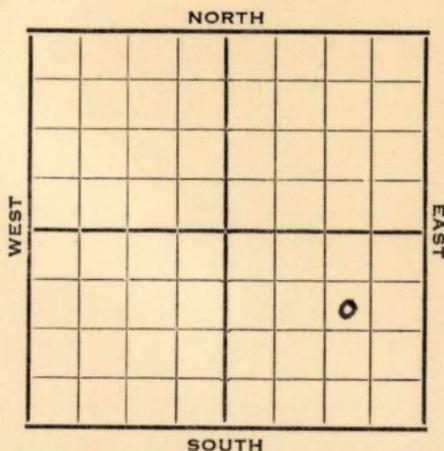

1952

**Elev. 2202'**

REPORT

6/11

Spud 6-4-52  
8" @ 493'  
Fishing @ 3349'

6/11

Fishing

6/18

Spud 6-4-52  
D&A TD 3890' 8" @ 493'  
**Top. 3233** **Heeb. 3454**  
**Lans. 3489**  
DST 3510-35 open 1 hr. rec. 130' sw  
DST 3617-35 open 1 hr. rec. 90' gas  
30' hocm  
DST 3642-54 open 1½ hr. rec. 95' sw  
DST 3660-85 open ½ hr. rec. 30' mud  
**Arb. 3886'**  
DST 3883-90 open ½ hr. rec. 332' o & w  
30' sw TD 3890' D&A

**ABANDONED**



