


Section 33 Township 25 Range 5-E

Well No. #99 Stokes

Company Cities Service

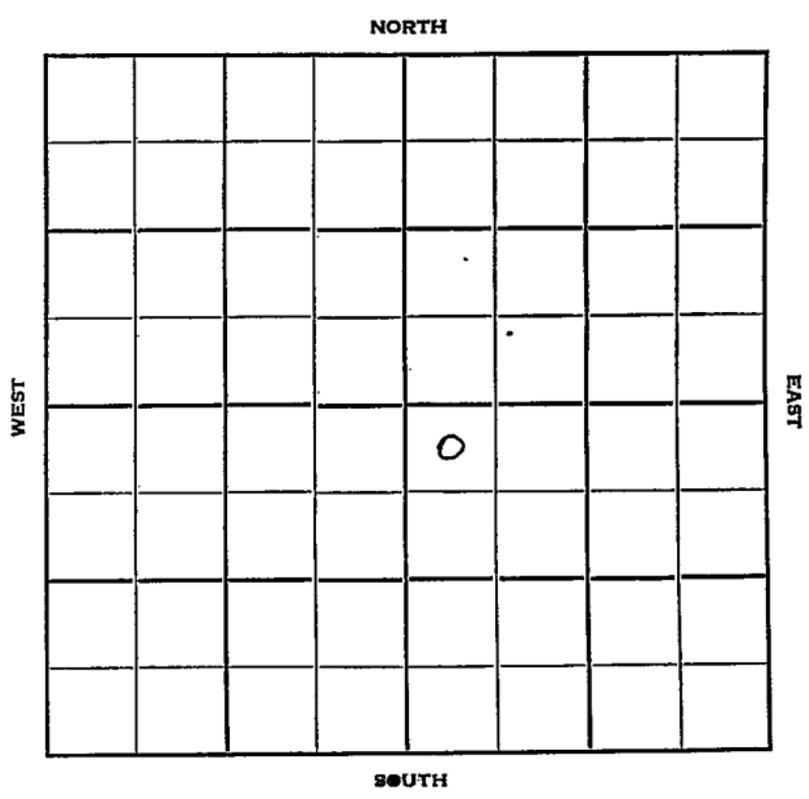

Sec. 33 Twp. 25 R. 5E

Well No. #99 Stokes Farm

Cities Service Company

Contractor


355' Ft. from N. Line

_____ Ft. from S. Line

_____ Ft. from E. Line

330' Ft. from W. Line

NW NW SE

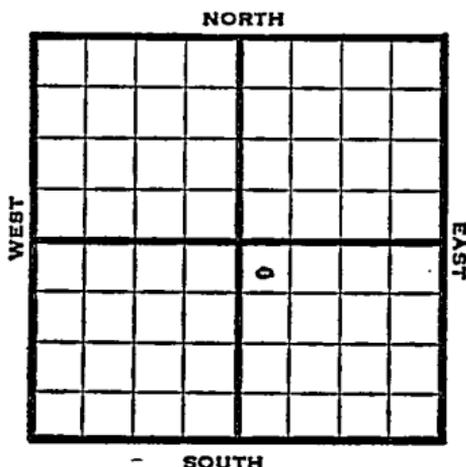

1950

Elev. 1357' REPORT

11/15

Drlg. 196'

1951
1/10

Oil Well TD 2416
 Lans. 1660 KC 1947'
 BKC 2122' Arb. 2403
 TD 2405 5" @ 2404
 DD 2416 250 A Comp. 11 bopd

COMPLETED

