

Butler


KANSAS

Section 33 Township 25 Range 5E

Well No. #100 Stokes

Company Cities Service

NORTH

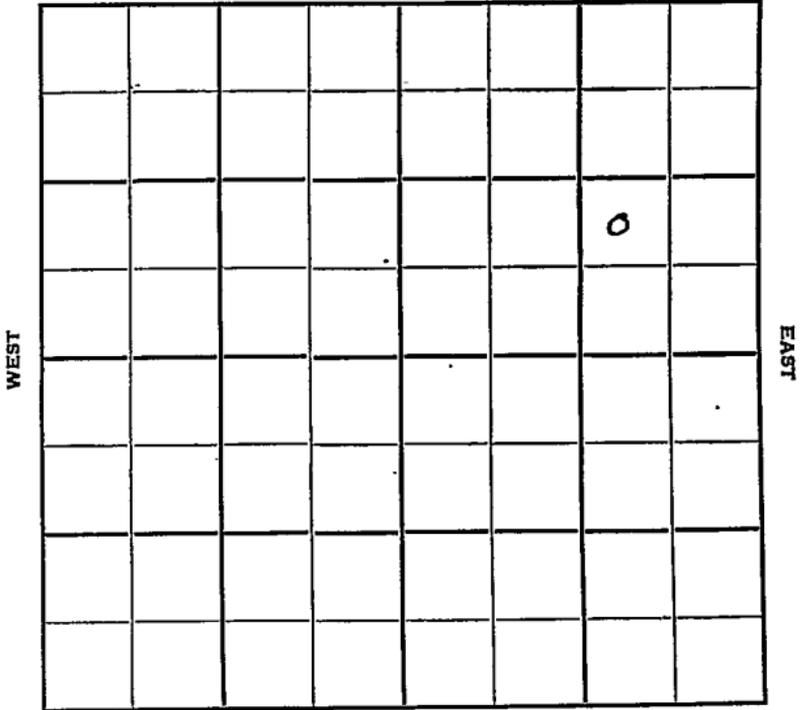

SOUTH

Butler

KANSAS
SE

Sec. 33 Twp. 25 R. ✓

Well No. #100 Stokes Farm

Cities Service Company

El Dorado Pool Contractor


 Ft. from N. Line

990' Ft. from S. Line

990' Ft. from E. Line

 Ft. from W. Line

NW SE NE

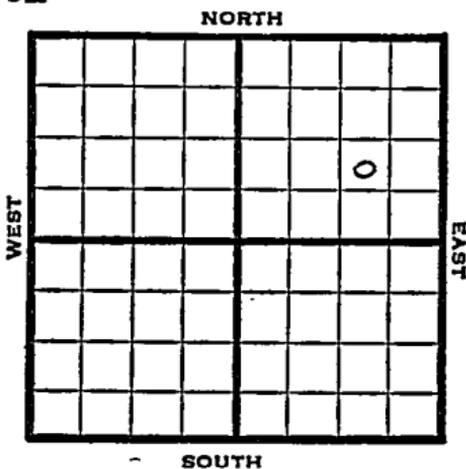

1950 Elev 1374' REPORT

12/6	Drlg. 355'	
12/20	8" @ 81	
	Lans 1657	KC 1960
	Arb 2391-93	
	5" @ 2392	
	TD 2393	
	Compl2 bopd	
	Completed	

COMPLETED

