


Section 30 Township 12 Range 21W

Well No. #1 Hillman

Company Welch & Olsson

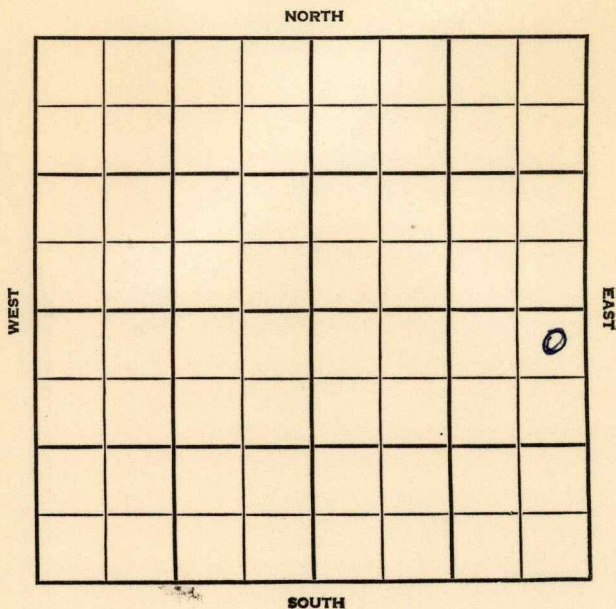

Trego

KANSAS

SEC.

30

TWP.

12

R.

21W

WELL NO.

#1 Hillman

FARM

COMPANY

Welch & Olsson

CONTRACTOR

Co. Tools

WILDCAT

____ FT. FROM N. LINE

____ FT. FROM S. LINE

____ FT. FROM E. LINE

____ FT. FROM W. LINE

NORTH

WEST

EAST

SOUTH

NE NE SE

1956

ELEVATION

2285'

REPORT

6-6

Comm. 6-4-56

8" @ 204 #/175

WOC

6-13

DST 3664-3719, op 1 hr, rec 620' msw

6-20

BHP 1195/ 30"

DST 3767-3804, op 45 min, rec 12' mud

BHP 0#

D & A

H. 3555', L. 3588', B.K.C. 3826',

C. 3961', A. 4010',

TD 4047'

ABANDONED

County Trego Elev. _____
 Sec. 30 Twp. 12 Rge. 21W
 Company Welch & Olsson
 FarmName Hillman No. 1

TOPS	DEPTH	LOG	DATUM	Loc. in Sec.
Anh.				<u>NE NE SE</u>
Tr.				
H.				
Tr.				
Dg.				
Bl.				
L.				Geol. _____
M.C.				Contr. _____
B.K.C.				
Ce.				<u>Co. tools</u>
C.				
M.				Pool _____
M.				<u>Wildcat</u>
K.				
Mz.				
Me.				
V.				
S.				
S.				
A.				
R.				
PE.				
G.				
T.D.				

FIRST REPORT

JUN 5 '56

Date Comm. 6-4-56
8" @ 204/175 WOC

JUN 11 1956

R.G.

Co.

Lse.

No.

Sec.

T.

R.

County Trigo Elev. 2285
 Sec. 30 Twp. 12 Rge. 21W
 Company Welch & Olsson
 Farm Name Hillman No. 1

TOPS	DEPTH	LOG	DATUM	Loc. in Sec.
Anh.				NE NE SE
TP.				
H.	3555			
Tr.				
Dg.				
Bl.				
L.	3588			Geol.
K.C.				Contr.
B.K.C.	3826			Co. tools
Ce.				Pool
C.	3961			Wildcat
M.				
M.				
K.				
Mz.				
Mo.				
V.				
S.				
S.				
A.	4010			ABANDONED
R.				
PE.				
G.				
TD.	4047			

Date Comm. 6-4-56 JUN 20 1956

8" @ 204/175 WOC JUN 13 '56

DST 3664-37#19 JUN 20 '56 ex 1 hr re
 620' MSW BHP 1195/30" DST
 3767-3804 45" res 12' Mud
 BHP 0

D&A