

KANSAS


FORM 51 BM 4-41 PETROL

Barton

Section 13 Township 17 Range 11-W

Well No. #1 Burmeister 'A' (KGS DRL)

Company Champlin Refining

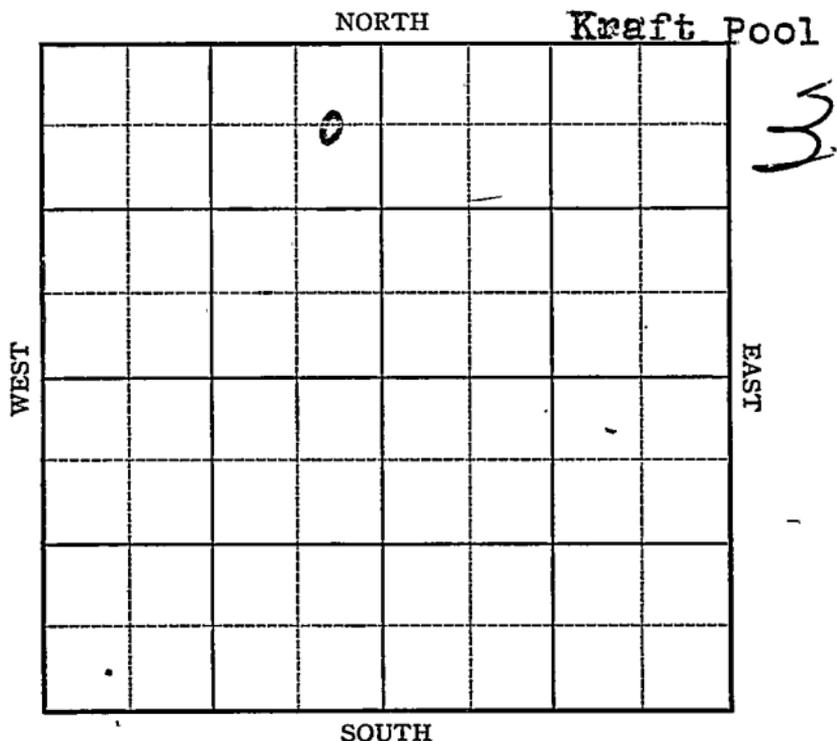

Map No. 55 Sec. 13 Twp. 17 R. 11WWell No. 1 Burmeister 'A' (KGS DRL)Champlin Refining CompanyFIRST REPORT

Contractor

SECTION PLAT

C E L N E N W


660 Ft. from N. Line

_____ Ft. from S. Line

330 Ft. from E. Line

_____ Ft. from W. Line

KRAFT POOL

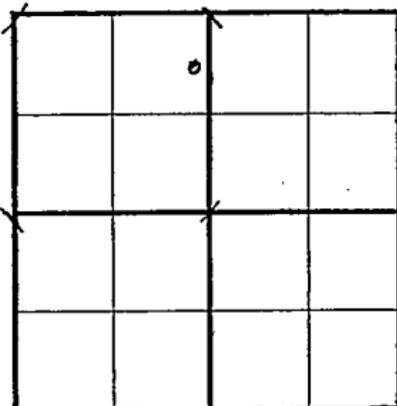

Location _____

Rig up _____

Drilling and Remarks:

10" - 305

Anhy. 650

Drlg. 1820

RECORD

Cased _____ in., _____ ft.

Sand _____

Gas _____

Oil _____

Total Depth _____

PRODUCTION

1st 24 hrs. Nat. _____

1st 24 hrs. after shot _____

Gas _____ Cu. Ft.

Dry Hole _____

Abandoned _____

Date

APR 9 1941 19S. J. LEWIS Scout

Map No. 55 Sec. 13 Twp. 17 R. 11W

Well No. 1 Burmeister 'A' (KGS DRL)

Champlin Refining Company

COMPLETED Contractor

SECTION PLAT

		2	

C E L N E N W

660 Ft. from N. Line

_____ Ft. from S. Line

330 Ft. from E. Line

_____ Ft. from W. Line

KRAFT POOL

Location _____

Rig up _____

Drilling and Remarks:

*Core 3336
5" C 3342.
Depth 1613*

48 6/8

RECORD

Cased _____ in., _____ ft.

Sand _____

Gas _____

Oil _____

Total Depth 3351

PRODUCTION

1st 24 hrs. Nat. _____

1st 24 hrs. after shot _____

Gas _____ Cu. Ft.

Dry Hole _____

Abandoned _____

Date

APR 30 1941 19

S. J. LEWIS Scout