


Section 13 Township 17 Range 11-W

Well Number #1 Peterman

Company Texas

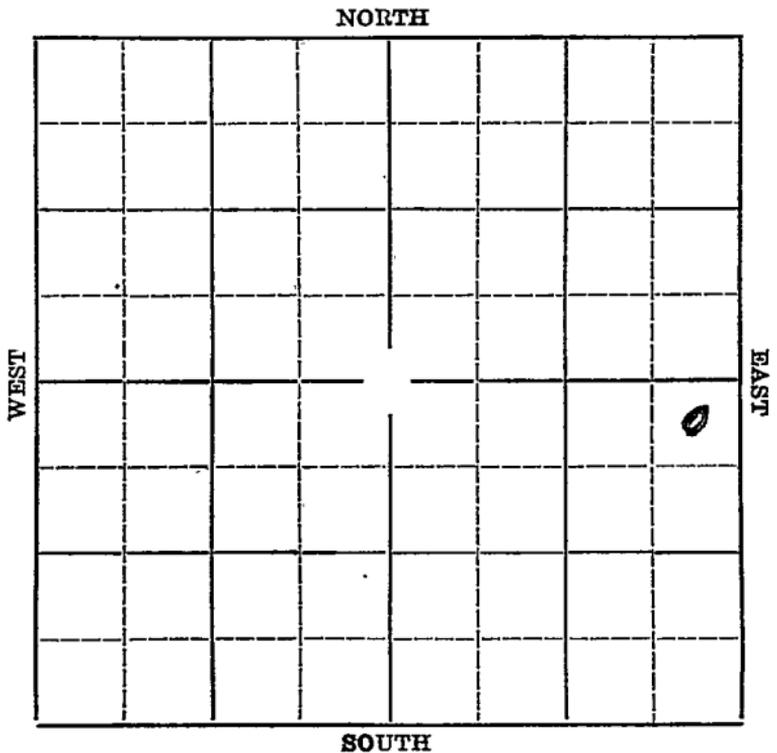

~~BUTLER~~
Barton

Map No. KANSAS Sec. 13 Twp. 17 R. 11W

Well No. #1 Peterman Farm
Texas Company


330' Ft. from N. Line

_____ Ft. from S. Line

330' Ft. from E. Line

_____ Ft. from W. Line

Elev. 1851

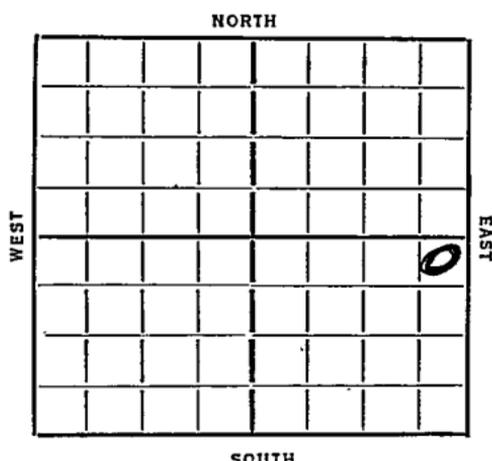

~~1936~~

REPORT

7/8 Location

7/16 -- 7/23 -- ~~7/30~~

7/30 Rig.

8/6 -- 8/13 -- 8/20 -- 8/27 -- 9/3 --

9/10 10" @ 198'. TD 205'. WOC.

9/18 Drlg. 2160'.

9/24 Drlg. 3255'.

10/1 Siliceous 3284'. TD 3293'.

Saturation. Rigging up st'd tools.

10/8 --

10/15 1000 gallons of acid. Swab 10 bbls of oil in 24 hours.

10/22 T.D. 3325' shot 25 qts. Collapsed. Casing swedging.

10/29 -- 11/6 -- 11/12 -- 11/19 -- 11/27 --

12/3 --

12/10 Cement back to 2600'.

12/17 -- 12/24 --

12/29 Sil. 3287½'. 7" @ 3289' RUST.

1937

1/7 T. D. 3325'. 800' oil in hole.

OVER

1937

1/14 Swabbed 90 bbls. 24 hrs.

1000 acid. No test.

1/21 Pumped 267 oil, 3% water.

3000 acid. No test.

1/27--Sil. 3287 $\frac{1}{2}$

T. D. 3325

1000 Acid

3000 Acid

Pump 216 Oil

13 $\frac{1}{2}$ Water

COMPLETED

Map No. 58 Sec. 13 Twp. 19 R. 11W

Well No. 1 P. Terman

Texas Company

Contractor

SECTION PLAT

280 Ft. from N. Line

_____ Ft. from S. Line

330 Ft. from E. Line

_____ Ft. from W. Line

			o

FIRST REPORT

Location ✓

Rig up _____

Drilling and Remarks:

RECORD

Cased _____ in., _____ ft.

Sand _____

Gas _____

Oil _____

Total Depth _____

PRODUCTION

1st 24 hrs. Nat. _____

1st 24 hrs. after shot _____

Gas _____ Cu. Ft.

Dry Hole _____

Abandoned _____

Date

JUL 8 1936 19

S. J. LEWIS

Scout

Map No. 55 Sec. 13 Twp. 17 R. 11W

Well No. 1 Peterman

Texas Company

Contractor

SECTION PLAT

330 Ft. from N. Line

_____ Ft. from S. Line

330 Ft. from E. Line

_____ Ft. from W. Line

			o

COMPLETED

Location _____

Rig up _____

Drilling and Remarks:

Oil 3287 1/2
1000 acid
3000 acid
Pump. 216 oil
13 1/2 water

RECORD

Cased _____ in., _____ ft.

Sand _____

Gas _____

Oil _____

Total Depth 3325

PRODUCTION

1st 24 hrs. Nat. _____

1st 24 hrs. after shot _____

Gas _____ Cu. Ft.

Dry Hole _____

Abandoned _____

Date

JAN 27 1937 19

S. J. LEWIS Scout