





Sec. 31 Twp. 12 R. 21 W

Well No. # 2 Monroe Farm

N C R A Company

Garvey Contractor


990 Ft. from N. Line

Ft. from S. Line

Ft. from E. Line

990 Ft. from W. Line

SE NW SW

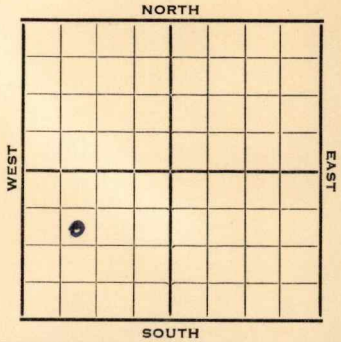

1952 Elev. 2314' REPORT

9/24 Spud 9-20-52  
8" @ 197 Anhy 1723'  
Drlg. 1968'

10/1 Heeb 3568, Tor 3586, Lans 3607,  
DST 3634-43 2 hrs., 550' SW  
1250#  
Drlg. 3809

10/8 Spud 9-20-52  
D&A TD 4100'  
8" @ 197'  
Anhy 1723 Heeb. 3568  
Tor. 3586 Lans. 3607  
DST 3634-43 open 2 hr. rec. 550' SW  
1250# Cong. 3915 Arb. 4006  
TD 4100' D&A

**ABANDONED**



