


Section 13 Township 17 Range 11-W

Well No. #2 Meyers

Company Transwestern et al

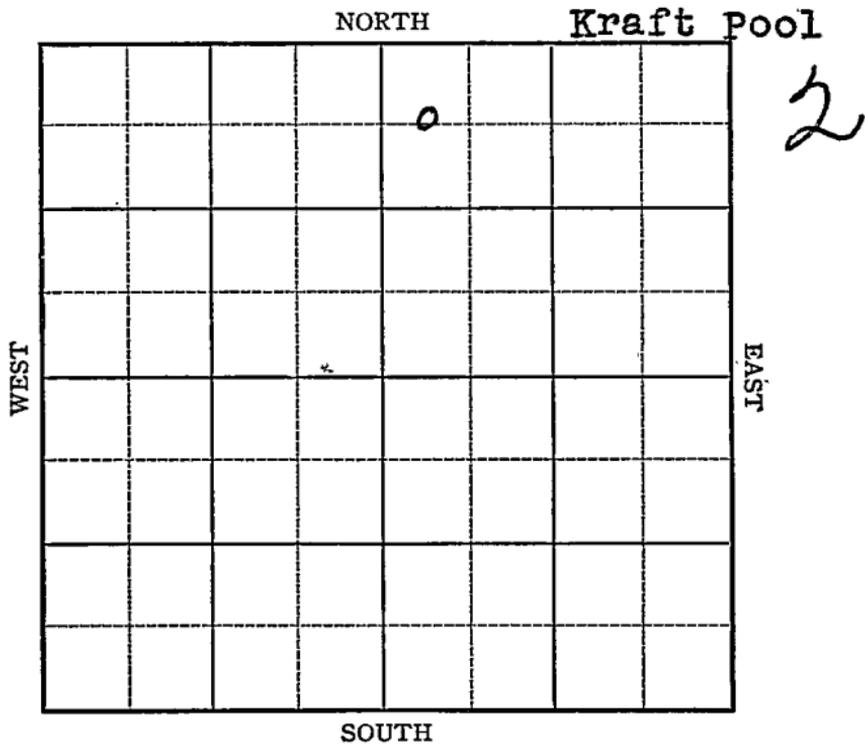

Sec. 13 Twp. 17 R. 11-W

Well No. #2 Meyers Farm

Transwestern et al Company

(Kraft)


660 Ft. from N. Line

_____ Ft. from S. Line

_____ Ft. from E. Line

330 Ft. from W. Line

Elev. 1870

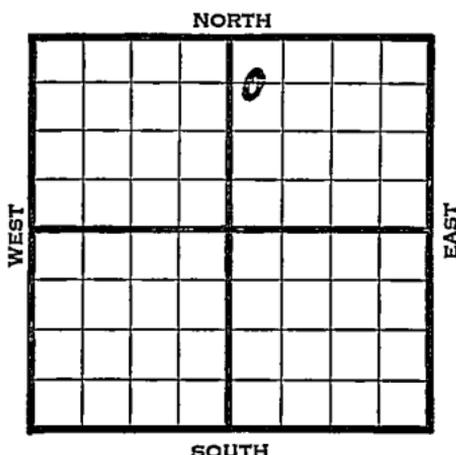

1941	REPORT
4/30	Location
5/8	8" - 249' WOC.
5/15	Drlg. 2806'
5/22	Lans. 2992' Arb. 3313-16' T.D. 5" - 3314' RUST.
5/28	T.D. 3321' 2500' oil 3½ hours.
6/4	Arb. 3313'
	5" - 3314'
	T.D. 3321'
	Depthograph potential 2951 bbls.
	43.6 Gravity
	COMPLETED

Map No. 55 Sec. 13 Twp. 17 R. 11W

Well No. 2 Meyers

Transwestern et al Company

Contractor

FIRST REPORT

SECTION PLAT

C W L NW NE

660 Ft. from N. Line

_____ Ft. from S. Line

_____ Ft. from E. Line

330 Ft. from W. Line

		o	

KRAFT POOL

Location X

Rig up _____

Drilling and Remarks:

RECORD

Cased _____ in., _____ ft.

Sand _____

Gas _____

Oil _____

Total Depth _____

PRODUCTION

1st 24 hrs. Nat. _____

1st 24 hrs. after shot _____

Gas _____ Cu. Ft.

Dry Hole _____

Abandoned _____

Date

APR 30 1941 19

S. J. LEWIS Scout

Map No. _____ Sec. 13 Twp. 17 R. 11W

Well No. 2 Meyers

Transwestern etal Company

COMPLETED Contractor

SECTION PLAT

C W L NW NE

660 Ft. from N. Line

_____ Ft. from S. Line

_____ Ft. from E. Line

330 Ft. from W. Line

KRAFT POOL

Location _____

Rig up _____

Drilling and Remarks:

CR 8313
5" @ 8314
Depth 2951

486 Gr.

RECORD

Cased _____ in., _____ ft.

Sand _____

Gas _____

Oil _____

Total Depth 2321

PRODUCTION

1st 24 hrs. - Nat. _____

1st 24 hrs. after shot _____

Gas _____ Cu. Ft.

Dry Hole _____

Abandoned _____

Date

JUN 4 1941 19

S. J. LEWIS Scout