


Section 31 Township 12 Range 21 W

Well No. # 1 Kellogg

Company Walters Drlg.

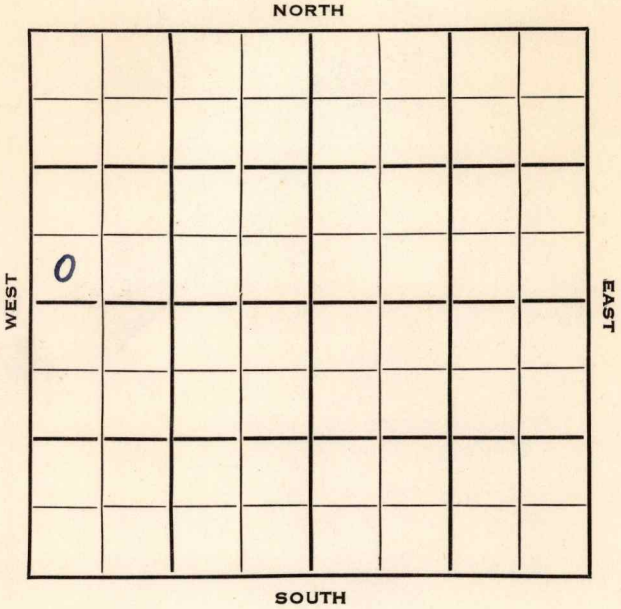

Trego


SEC. 31 TWP. 12 R. ~~KANSAS~~ 21W ✓

WELL NO. #1 Kellogg FARM

COMPANY Walters Drlg.

CONTRACTOR

_____ Ft. from N. Line
330 _____ Ft. from S. Line
 _____ Ft. from E. Line
330 _____ Ft. from W. Line

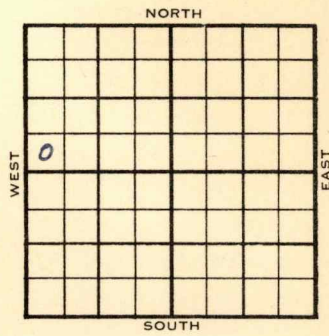

SW SW NW
 Continental acreage.

	ELEVATION	REPORT
1953	2320'	
11/18	Spud 11-14-53 8" @ 190'	Drlg 1021'
12/2	Spud 11-14-53 D&A TD 4034' 8" @ 190' Heeb 3585', Tor 3601', Lans 3618', Simp. 3982', Arb. 3993' DST 3995-98', opn 1 hr., rec. 10' mud, Off DST 3998-4007', opn 1 hr., rec. 15' mud Off DST 4007-14', opn 1 hr., rec. 50' socm 340# TD 4034 D&A	
ABANDONED		

