

KANSAS


FORM 51 5M PETROL

Barton

Section 13 Township 17 Range 11W

Well No. #2 Burmester "B"

Company Champlin Ref.

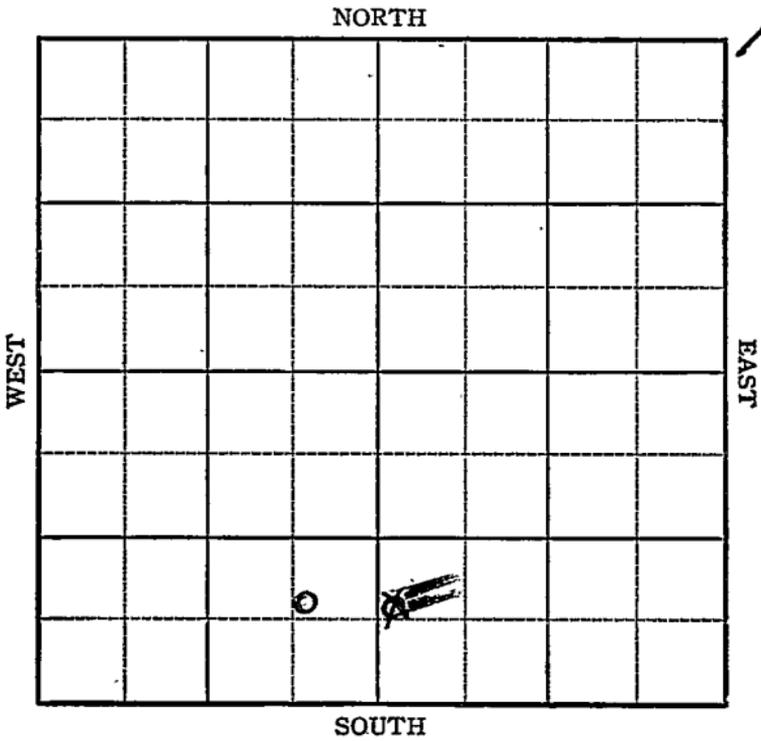

Sec. 13 Twp. 17 R. 11W

Well No. #2 Burmester "B" Farm

Champlin Ref. Company

Kraft Prusa


_____ Ft. from N. Line

890 Ft. from S. Line

561 Ft. from E. Line

_____ Ft. from W. Line

lev. 1890

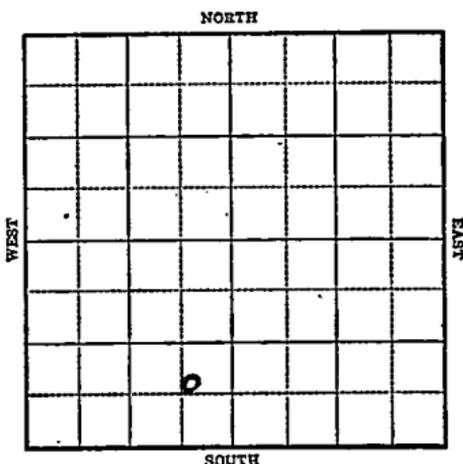

1944

R E P O R T

2/23 Location

3/1 Derrick

3/8 "

3/16 Rotary

3/22 8" @ 240
Drlg. 1610

3/29 Anhy 1432 ?
Drlg. 3178

4/5 Arb 3348
Drlg. 3505 for SWD

4/12 Reagan 3560
Granite Wash 3575
TD 3635
4 @ 3463
Rust

4/19 "

4/26 "

5/3 SD

5/10 "

5/17 "

5/24 "

5/31 "

OVER

1944

6/7 TD 3635' SD
6/15 " " "
6/21 " " "
6/28 " " "
7/12 " " "
7/19 " " "
7/26 " " " "
8/2 " " "
8/9 " " "
8/16 " " "
8/23 " " "
8/30 " " "
9/6 Reagan 3560
4" @ 3463
Granite 3575
TD 3635 \ Wash
SWD

ABANDONED

KANSAS 55
 Map No. 55 Sec. 13 Twp. 17 R. 11W

Well No. 2 Burmester "B"

Champlin Ref. Company

FIRST REPORT

Contractor

C E L S E S W

SECTION PLAT

 Ft. from N. Line

890 Ft. from S. Line

561 Ft. from E. Line

 Ft. from W. Line

Kraft Prusa Pool

Location X

Rig up

Drilling and Remarks:

RECORD

Cased in., ft.

Sand

Gas

Oil

Total Depth

PRODUCTION

1st 24 hrs. Nat.

1st 24 hrs. after shot

Gas Cu. Ft.

Dry Hole

Abandoned

Date

FEB 23 1944 19

S. J. LEWIS Scout

