


Trego

KANSAS

Section 35 Township 12 Range 21-W

Well Number 1 Duncan

Company Rose Spring Drlg. et al

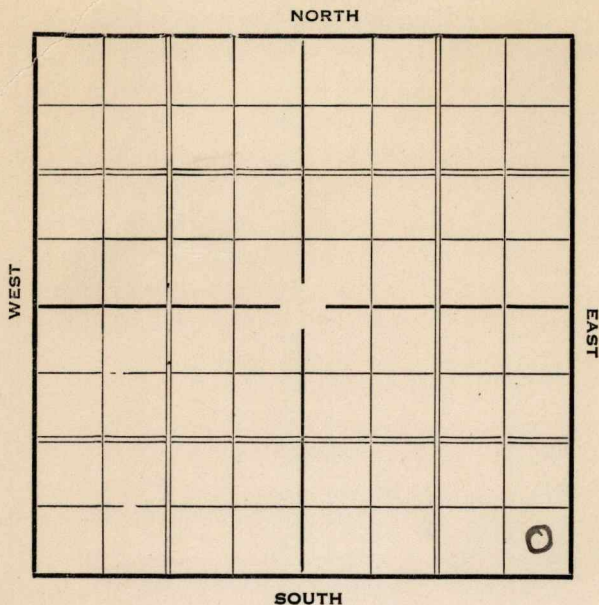

KANSAS*Trego*Map No. 70 Sec. 35 Twp. 12 R. 21WWell No. 1 DuncanRose Spring Oil & Gas Company

Contractor

SECTION PLAT

 Ft. from N. Line330 Ft. from S. Line330 Ft. from E. Line Ft. from W. Line**FIRST REPORT**Location Rig up

Drilling and Remarks:

*Rig***RECORD**Cased in., ft.Sand Gas Oil Total Depth **PRODUCTION**1st 24 hrs. Nat. 1st 24 hrs. after shot Gas Cu. Ft.Dry Hole Abandoned

Date

APR 7 1937 19S. J. LEWIS

Scout

Trego

KANSAS

Map No. 70 Sec. 35 Twp. 12 R. 21^WWell No. 1-DuncanRose Spring etal Company
Contractor

ABANDONED

SECTION PLAT

			0

 Ft. from N. Line330 Ft. from S. Line330 Ft. from E. Line Ft. from W. LineLocation Rig up

Drilling and Remarks:

small S.O. 3871-74H.F.W.3874-76D & A

RECORD

Cased 6 in., 3868 ft.Sand Sil 3867Gas Oil Total Depth 3876

PRODUCTION

1st 24 hrs. Nat. 1st 24 hrs. after shot Gas Cu. Ft.Dry Hole Abandoned

Date

JUN 2 1937 19H. D. Hatfield

Scout