


Section 13 Township 17 Range 11-W

Well No. #4 Peterman

Company Texas

16

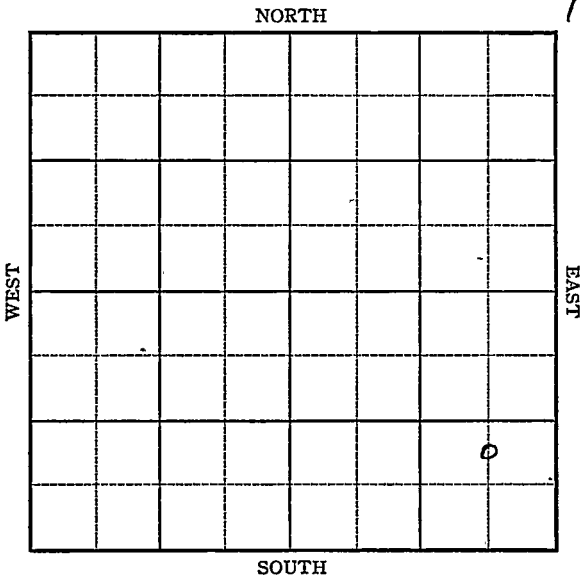

Sec. 13 Twp. 17 R. 11-W

Well No. #4 Peterman Farm


Texas Company

_____ Ft. from N. Line

990 Ft. from S. Line

660 Ft. from E. Line

_____ Ft. from W. Line

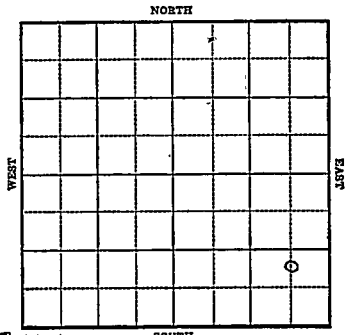

Elev. 1854

1944

R E P O R T

- 1-12 Location
- 1/19 "
- 1/26 8" @ 3354-300' oil
- 2/2 Arb 3329
Drlg. 3331'
- 2/8 TD 3385
5" @ 3384
Rust
- 2/15 "
- 2/23 8" @ 251
Drlg. 650'
- 2/23 5" @ 3384
Arb 3329
Td 3385'
Water.

ABANDONED

Barton

KANSAS

Map No. 55 Sec. 13 Twp. 17 R. 11W

Well No. 4 Peterman

Texas Company

ABANDONED Contractor

C N L SE SE

SECTION PLAT

_____ Ft. from N. Line

990 Ft. from S. Line

660 Ft. from E. Line

_____ Ft. from W. Line

Kraft Prusa Pool

Location _____

Rig up _____

Drilling and Remarks:

Cor 83329

5" @ 3384

Water.

RECORD

Cased _____ in., _____ ft.

Sand _____

Gas _____

Oil _____

Total Depth 3385

PRODUCTION

1st 24 hrs. Nat. _____

1st 24 hrs. after shot _____

Gas _____ Cu. Ft.

Dry Hole _____

Abandoned _____

Date _____

FEB 23 1944 19

S. J. LEWIS Scout