


Section 13 Township 17 Range 11W

Well No. #5 Peterman

Company Texas

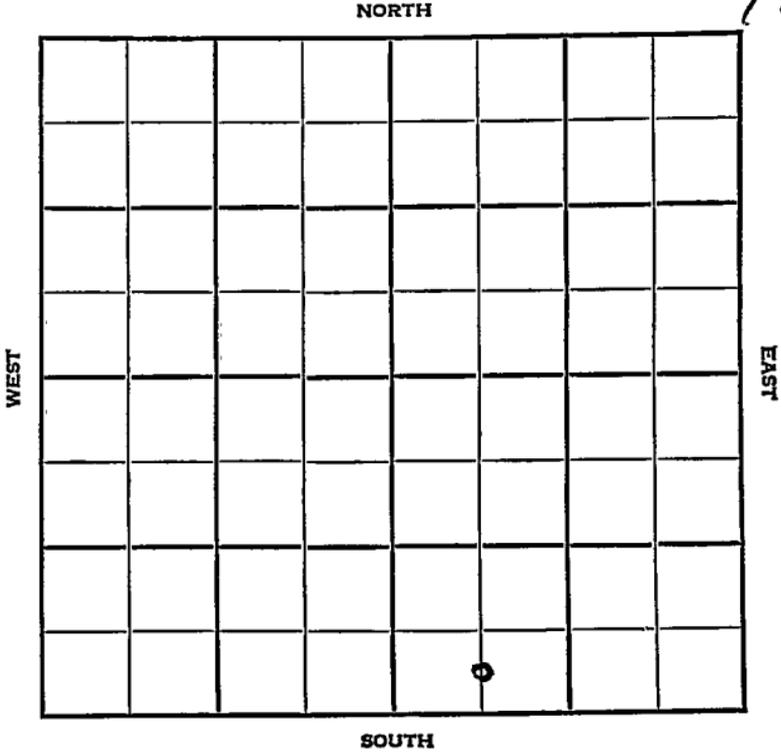

Sec. 13 Twp. 17 R. 11W

Well No. #5 Peterman Farm

Texas Company

Kraft-Prusa


         Ft. from N. Line

330 Ft. from S. Line

         Ft. from E. Line

660 Ft. from W. Line

C S L SW SE

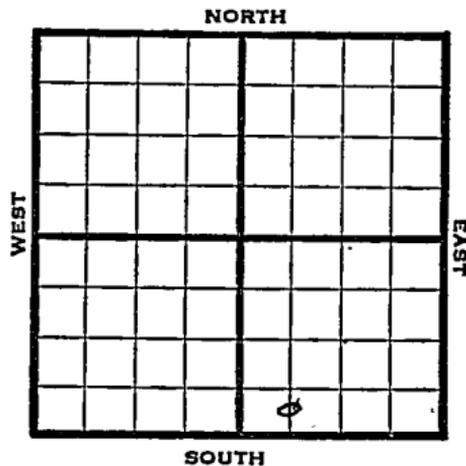

1948

Elev. 1861'

REPORT

1/28

Location

2/4

8" @ 634'  
Drlg. 1395'

2/11

10" @ 317'

2/18

Lansing 3006'  
Arbuckle 3313  
5" @ 3316'  
TD 3318'  
500 acid  
Swb 42 bbls oil 3 hrs.

2/25

"

3/3

Arbuckle 3313'  
5" @ 3316'  
500 Acid  
Depth Pot 1745'  
Gr. 43°  
Total Depth 3318'  
**COMPLETED**

Kansas

Map No. \_\_\_\_\_ Sec. 13 Twp. 17 R. 11WWell No. 5 Peterman

Texas

Company \_\_\_\_\_

## FIRST REPORT

Contractor \_\_\_\_\_


C S L SW SE

## SECTION PLAT

\_\_\_\_\_ Ft. from N. Line

330 Ft. from S. Line

\_\_\_\_\_ Ft. from E. Line

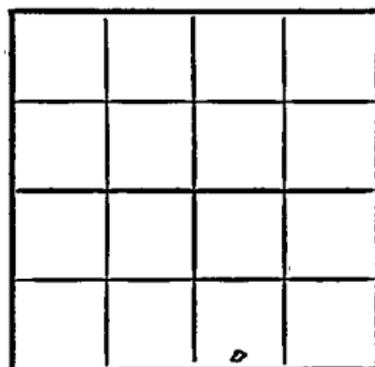660 Ft. from W. Line

Barton County

Location X

Rig up \_\_\_\_\_

Drilling and Remarks:

## RECORD

Cased \_\_\_\_\_ in., \_\_\_\_\_ ft.

Sand \_\_\_\_\_

Gas \_\_\_\_\_

Oil \_\_\_\_\_

Total Depth \_\_\_\_\_

## PRODUCTION

1st 24 hrs. Nat. \_\_\_\_\_

1st 24 hrs. after shot \_\_\_\_\_

Gas \_\_\_\_\_ Cu. Ft.

Dry Hole \_\_\_\_\_

Abandoned \_\_\_\_\_

Date

JAN 28 1948

19

S. J. LEWIS Scout

Map No. 55 Sec. 13 Twp. 17 R. 11W

Well No. 5 Peterman

Texas Company

**COMPLETE** Contractor

C S L SW SE

*E. 11861*  
SECTION PLAT

         Ft. from N. Line

330 Ft. from S. Line

         Ft. from E. Line

660 Ft. from W. Line


Barton County

Location                                 

Rig up                                 

Drilling and Remarks:

*Per 8313*  
*5' @ 816*  
*500000'*  
*Depth 1745*  
*48 2/3'*

**RECORD**

Cased          in.,          ft.

Sand                                 

Gas                                 

Oil                                 

Total Depth 8315

**PRODUCTION**

1st 24 hrs. Nat.                                 

1st 24 hrs. after shot                                 

Gas                                  Cu. Ft.

Dry Hole                                 

Abandoned                                 

Date

MAR 3 1948 19

S. J. LEWIS Scout