


Section 13 Township 17 Range 11W

Well No. 3 Peterman

Company Texas


15

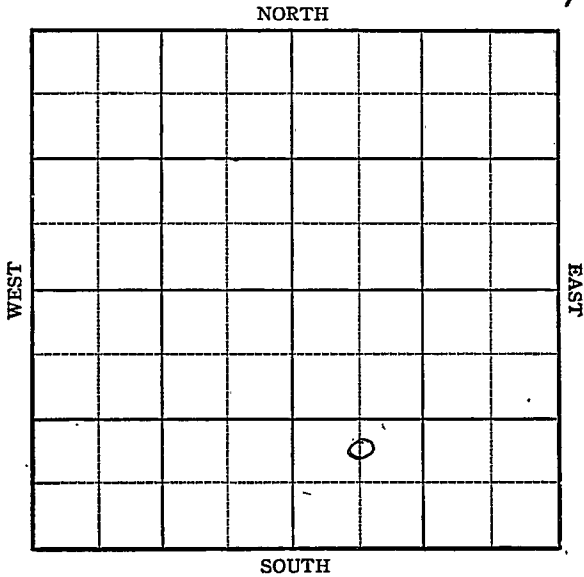

Sec. 13 Twp. 17 R. 11-W

Well No. #3 Peterman Farm  
Texas Company

NORTH

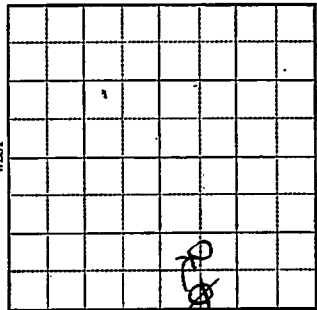

\_\_\_\_\_ Ft. from N. Line

990  
~~330~~

\_\_\_\_\_ Ft. from S. Line

\_\_\_\_\_ Ft. from E. Line

660 \_\_\_\_\_ Ft. from W. Line

Elev. 1865

1943

R E P O R T

- 11/17 Location.
- 11/24 8" @ 258  
Drlg. 1735'
- 12/1 Topeka 2648  
Drlg 2950'
- 12/8 Arb 3320-22 TD  
5" @ 3322  
RUST
- 12-15 TD 3329'  
Pump 238 oil in 24 hrs.
- 12/22 5" @ 3322  
Arb 3320  
Pump 238 Pot  
TD 3329  
Gravity 42.4

COMPLETED

**KANSAS**

Map No. 55 Sec. 13 Twp. 17 R. 11W

Well No. 3 Peterman

Texas

Company

**FIRST REPORT**

Contractor

**C S L SW SE**

**SECTION PLAT**

\_\_\_\_\_ Ft. from N. Line

330 Ft. from S. Line

\_\_\_\_\_ Ft. from E. Line

660 Ft. from W. Line

		C ↑ O	

**Kraft Prusa Pool**

Location X

Rig up \_\_\_\_\_

Drilling and Remarks:

**RECORD**

Cased \_\_\_\_\_ in., \_\_\_\_\_ ft.

Sand \_\_\_\_\_

Gas \_\_\_\_\_

Oil \_\_\_\_\_

Total Depth \_\_\_\_\_

**PRODUCTION**

1st 24 hrs. Nat. \_\_\_\_\_

1st 24 hrs. after shot \_\_\_\_\_

Gas 307 \_\_\_\_\_ Cu. Ft.

Dry Hole \_\_\_\_\_

Abandoned \_\_\_\_\_

Date

NOV 17 1943 19

S. J. LEWIS Scout

Map No. 55 Sec. 13 Twp. 17 R. 11W

Well No. 3 Peterman

Texas Company

CORRECTION Contractor

C N L SW SE

SECTION PLAT

		o	

\_\_\_\_\_ Ft. from N. Line

990 Ft. from S. Line

\_\_\_\_\_ Ft. from E. Line

660 Ft. from W. Line

Location \_\_\_\_\_

Rig up \_\_\_\_\_

Drilling and Remarks:

Reported

C S L SW SE

RECORD

Cased \_\_\_\_\_ in., \_\_\_\_\_ ft.

Sand \_\_\_\_\_

Gas \_\_\_\_\_

Oil \_\_\_\_\_

Total Depth \_\_\_\_\_

PRODUCTION

1st 24 hrs. Nat. \_\_\_\_\_

1st 24 hrs. after shot \_\_\_\_\_

Gas \_\_\_\_\_ Cu. Ft.

Dry Hole \_\_\_\_\_

Abandoned \_\_\_\_\_

Date

NOV 17 1943

S. J. LEWIS

Scout

