

Section 34 Township 12 S Range 21 WWell No. #1 MerrillCompany Thunderbird

NORTH

|  |  |  |  |   |  |  |  |
|--|--|--|--|---|--|--|--|
|  |  |  |  |   |  |  |  |
|  |  |  |  | 0 |  |  |  |
|  |  |  |  |   |  |  |  |
|  |  |  |  |   |  |  |  |
WEST

EAST

SOUTH

Trego

KANSAS

|      |      |     |
|------|------|-----|
| SEC. | TWP. | R.  |
| 34   | 12S  | 21W |

WELL NO.

#1 Merrill

FARM

COMPANY

Thunderbird

CONTRACTOR


Wildcat

Ft. from N. Line

Ft. from S. Line

Ft. from E. Line

Ft. from W. Line

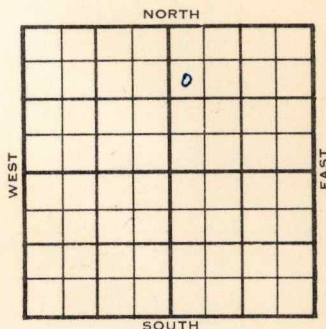

SW NW NE

Texas Support

1955

ELEVATION

2221'

REPORT

9/28

Comm 9-23-55  
 8" @ 205 w/115  
 D 850

10/19

Comm 9-23-55  
 8" @ 205/115

Anh

1596

Tp

3265

H

3476

Tr

3496

L

3513

A

3980

TD

3898

8" @ 205/115 DST 3596-3600 open 1 hr

Rec 255' sw 1155# DST 3662-3713

open 1 hr r/c 5' mud 0# DST

3891-98 open 1 hr rec 190' oil

1060# 5 1/2" @ 3892 CO to 3898

S/2 bfph 29% oil 250 A S/5 bfph

6% oil

D &amp; A

ABANDONED

County

Trego

Elev.

Sec.

34

Twp.

12S

Rge.

21W

Company

Thunderbird

FarmName

Merrill

No.

1

TOPS

DEPTH

LOG

DATUM

Loc. in Sec.

Anh.

SW NW NE

T.P.

H.

Tr.

Dg.

B.L.

L.

K.C.

B.K.C.

Ce.

C.

M.

M.

K.

Mz.

Mq.

V.

S.

S.

A.

R.

P.E.

G.

T.D.

Texas-Support

Geol.

Contr.

Pool

Wildcat

FIRST REPORT

Date Comm. 9-23-55

SEP 28 1955

8" 205 w/115; D 850

Co.

Lse.

No.

Sec.

T.

R.

County Trego Elev. 2221  
 Sec. 34 Twp. 12 Rge. 21W  
 Company Thunderbird  
 Farm Name Merrill No. 1

| TOPS   | DEPTH | LOG | DATUM |
|--------|-------|-----|-------|
| Anh.   | 1596  |     |       |
| Tp.    | 3265  |     | 1044  |
| H.     | 3476  |     | 1255  |
| Tr.    | 3496  |     | 1275  |
| Dg.    |       |     |       |
| Bl.    |       |     |       |
| L.     | 3513  |     | 1292  |
| K.C.   |       |     |       |
| B.K.C. |       |     |       |
| Ce.    |       |     |       |
| C.     |       |     |       |
| M.     |       |     |       |
| M.     |       |     |       |
| K.     |       |     |       |
| Mz.    |       |     |       |
| Mo.    |       |     |       |
| V.     |       |     |       |
| S.     |       |     |       |
| S.     |       |     |       |
| A.     | 3890  |     | 1669  |
| R.     |       |     |       |
| Pe.    |       |     |       |
| G.     |       |     |       |
| T.D.   | 3898  |     |       |

Loc. in Sec. SW NW NE

Geol. \_\_\_\_\_

Contr. \_\_\_\_\_

Pool \_\_\_\_\_

Wildcat



Date Comm. 9-23-55

OCT 19 1955

8" @ 205/115 DST 3596-3600 open 1 hr.

Rec. 255' SW 1155# DST 3662-3713

open 1 hr. Rec. 5' mud 0#

DST 3891-98 open 1 hr. rec. 190' oil

1060# 5 1/2" @ 3892 CO to 3898

S/ 2 bfph 29% oil 250 A

S/ 5 bfph 6% oil

D & A