


Section 13 Township 17 Range 11W

Well No. 4 Meyers B

Company Sunray

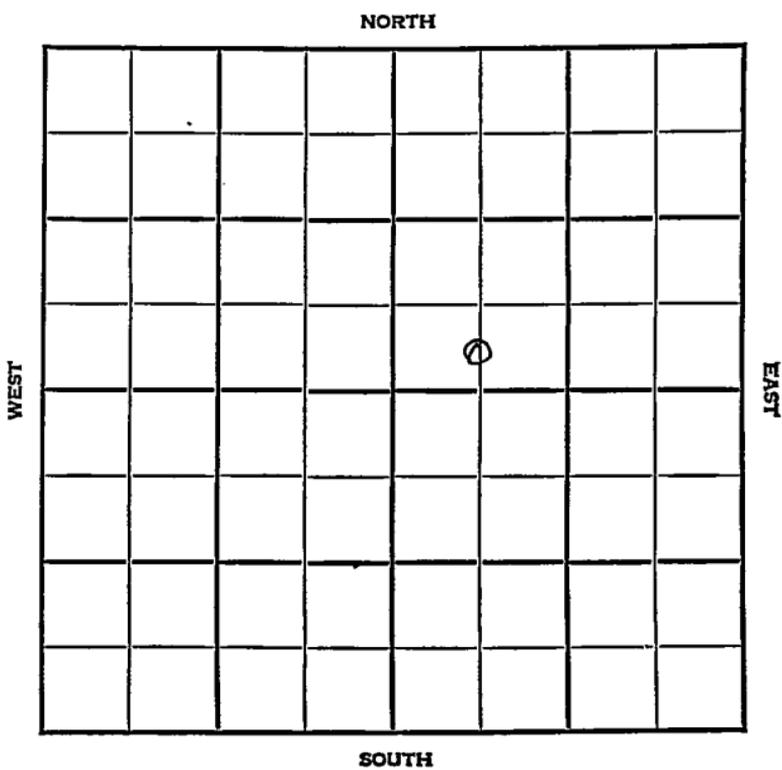

Sec. 13 Twp. 17 R. 11W

Well No. #4 Meyers "B" Farm

Sunray Company

Kraft-Prusa


 Ft. from N. Line

330 Ft. from S. Line

 Ft. from E. Line

660 Ft. from W. Line

C S L SW NE

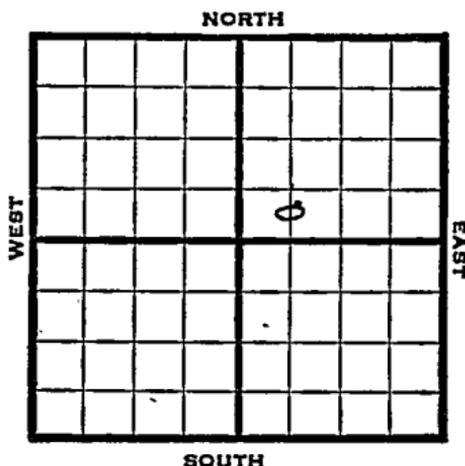

1947 Elev. 1879' REPORT

12/17 Surface hole.

12/30 10" @ 305'
Lansing 3012'
Arbuckle 3303-08' TD
7" @ 3305'
RUST

1948
1/7 "

1/14 Arb. 3303'
7" @ 3305'
Pump 361 Pot
42.0 Gr.
TD 3322'
Comp.

COMPLETED

Map No. _____ Sec. 13 Twp. 17 R. 11W

Well No. 4 Meyers "B"

Sunray Company

FIRST REPORT Contractor

C S L SW NE

SECTION PLAT

		o	

_____ Ft. from N. Line

330 Ft. from S. Line

_____ Ft. from E. Line

660 Ft. from W. Line

Barton County

Location _____

Rig up _____

Drilling and Remarks:

surface hole

RECORD

Cased _____ in., _____ ft.

Sand _____

Gas _____

Oil _____

Total Depth _____

PRODUCTION

1st 24 hrs. Nat. _____

1st 24 hrs. after shot _____

Gas _____ Cu. Ft.

Dry Hole _____

Abandoned _____

Date

DEC 17 1947

19

S. J. LEWIS

Scout

Map No. 55 Sec. 13 Twp. 17 R. 11W

Well No. 4 Meyers "B"

Sunray

Company

COMPLETE

Contractor

C S L SW NE

E. 11879
SECTION PLAT

 Ft. from N. Line

330 Ft. from S. Line

 Ft. from E. Line

660 Ft. from W. Line

Barton County

Location

Rig up

Drilling and Remarks:

Per 83303

> " 83305

Pump 36 Prod.

#2 2/2

RECORD

Cased in., ft.

Sand

Gas

Oil ✓

Total Depth 83305

PRODUCTION

1st 24 hrs. Nat.

1st 24 hrs. after shot

Gas Cu. Ft.

Dry Hole

Abandoned

Date

JAN 14 1948 19

S. J. LEWIS

Scout