


Section 13 Township 17 Range 11W

Well No. #6 Peterman

Company Texas  
Kraft-Prusa Pool

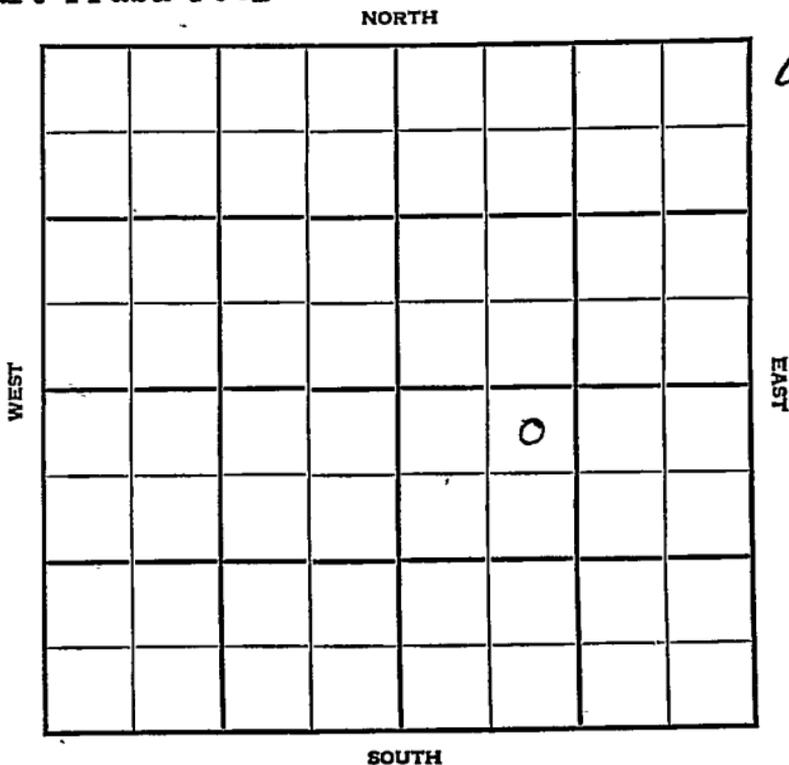

10

Sec. 13 Twp. 17 R. 11W

Well No. #6 Peterman Farm

Texas Company


Kraft-Prusa Pool

330 Ft. from N. Line  
8

\_\_\_\_\_ Ft. from S. Line

\_\_\_\_\_ Ft. from E. Line

990 Ft. from W. Line

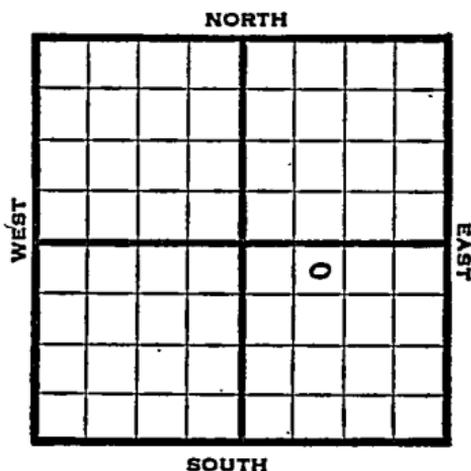

NE NW SE

1948	El. 1872'	REPORT
2/18		Location
2/25	8" @ 647'	Drlg. 860'
3/3		Drlg. 3342'
3/10		Arbuckle 3338-47' TD 3347' 5" @ 3341' RUST
3/17		TD 3304½' 1000' oil 1¼ hrs.
3/24		"
3/31		PB 3275' 54 shots 3116-3258' 2500 Acid Swb 2 gals oil & 3 gals W PH Plug 3064-23 shots 3025-36 500 acid 1½ bailers W PH
4/7		Arbuckle 3338' TD 3347'
		<b>ABANDONED</b>

Map No. \_\_\_\_\_ Sec. 13 Twp. 17 R. 11W

Well No. 6 Peterman

Texas Company

**FIRST REPORT**

Contractor

NE NW SE

**SECTION PLAT**

330 Ft. from N. Line

330 Ft. from S. Line

\_\_\_\_\_ Ft. from E. Line

990 Ft. from W. Line

		o	

Barton County

Location X

Rig up \_\_\_\_\_

Drilling and Remarks:

**RECORD**

Cased \_\_\_\_\_ in., \_\_\_\_\_ ft.

Sand \_\_\_\_\_

Gas \_\_\_\_\_

Oil \_\_\_\_\_

Total Depth \_\_\_\_\_

**PRODUCTION**

1st 24 hrs. Nat. \_\_\_\_\_

1st 24 hrs. after shot \_\_\_\_\_

Gas \_\_\_\_\_ Cu. Ft.

Dry Hole \_\_\_\_\_

Abandoned \_\_\_\_\_

Date

FEB 18 1948 19

S. J. LEWIS Scout

Map No. 55 Sec. 13 Twp. 17 R. 11W

Well No. 6 Peterman

Texas

Company

**ABANDONED**

Contractor

NE NW SE

*E. 1972*  
SECTION PLAT

330 Ft. from N. Line

\_\_\_\_\_ Ft. from S. Line

\_\_\_\_\_ Ft. from E. Line

990 Ft. from W. Line

		6	

Barton County

Location \_\_\_\_\_

Rig up \_\_\_\_\_

Drilling and Remarks:

*Car 8338*

RECORD

Cased \_\_\_\_\_ in., \_\_\_\_\_ ft.

Sand \_\_\_\_\_

Gas \_\_\_\_\_

Oil \_\_\_\_\_

Total Depth 3847

PRODUCTION

1st 24 hrs. Nat. \_\_\_\_\_

1st 24 hrs. after shot \_\_\_\_\_

Gas \_\_\_\_\_ Cu. Ft.

Dry Hole \_\_\_\_\_

Abandoned \_\_\_\_\_

Date

APR 7 1948

19

S. J. LEWIS

Scout