

KANSAS


Trego

FORM 51 5M PETROL

Section 36 Township 12 Range 21-W

Well No. #1-"A" Percy Gugler

Company ~~Hollow etal~~ Bridgeport oil

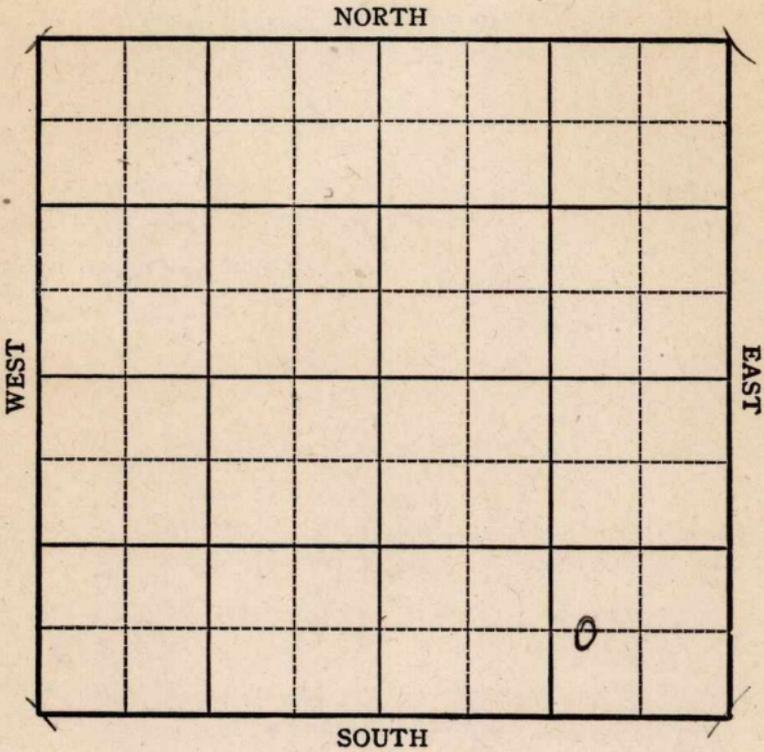

Sec. 36 Twp. 12 R. 21-W

Well No. #1-A Percy Gugler Farm


~~Hollowetal~~ Bridgeport oil Company

\_\_\_\_\_ Ft. from N. Line

660 Ft. from S. Line

996 Ft. from E. Line

\_\_\_\_\_ Ft. from W. Line

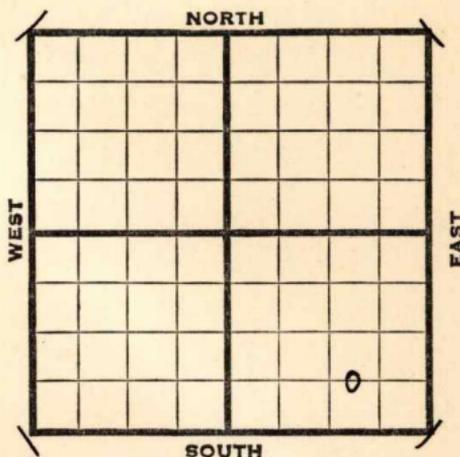

ELEV. 2203

1943

REPORT

9/1

SH

9/8

8" @ 123

Anhy 1542

Drlg. 2600'

9/15

Anhy 1570 correct 3d

Topeka 3203

Sat 3250-54, 3306-15,

Lans 3483

BKC 3715,

Congl 3802

Drlg. 3870'

9/22

Arb 3865

5" @ 3865

T.D. 3869

2500' oil no water.

9/29

" " " "

10/6

Pump 100 oil in 5 hrs.

**OVER**

1943

10/13

A rb 3865

5" @ 3865

Pump 385 Pot.

T.D. 3869

Gravity 31.6

**COMPLETED**

KANSAS

Map No. 70 Sec. 36 Twp. 12 R. 21W

Well No. 1-"A" Percy Gugler

Hollow etal Company

FIRST REPORT

Contractor

C W L SE SE


SECTION PLAT

Ft. from N. Line

660 Ft. from S. Line

996 Ft. from E. Line

Ft. from W. Line

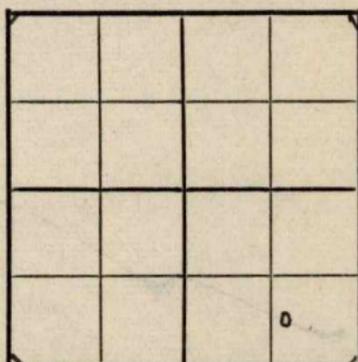

Ogallah Pool

Location

Rig up

Drilling and Remarks:

SH

RECORD

Cased in., ft.

Sand

Gas

Oil

Total Depth

PRODUCTION

1st 24 hrs. Nat.

1st 24 hrs. after shot

Gas Cu. Ft.

Dry Hole

Abandoned

Date

SEP 1 1943 19

S. J. LEWIS Scout

Trego

Map No. 70 Sec. 36 Twp. 12 R. 21W

Well No. 12-A" Perey Gugler

Bridgeport Oil


Company

CORRECTION

Contractor

C W L S E S E

SECTION PLAT

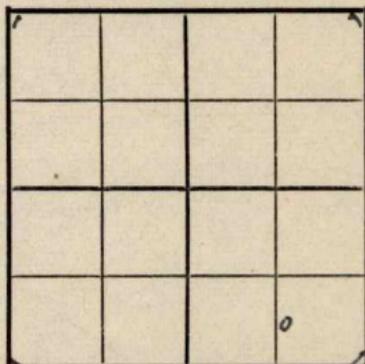

Ft. from N. Line

660 Ft. from S. Line

996 Ft. from E. Line

Ft. from W. Line

Ogallah Pool

RECORD

Location \_\_\_\_\_

Cased \_\_\_\_\_ in., \_\_\_\_\_ ft.

Rig up \_\_\_\_\_

Sand \_\_\_\_\_

Drilling and Remarks:

Gas \_\_\_\_\_

Oil \_\_\_\_\_

All Hollow  
Drlg. Co. are  
now Bridgeport  
Oil.

Total Depth \_\_\_\_\_

PRODUCTION

1st 24 hrs. Nat. \_\_\_\_\_

1st 24 hrs. after shot \_\_\_\_\_

Gas \_\_\_\_\_ Cu. Ft.

Dry Hole \_\_\_\_\_

Abandoned \_\_\_\_\_

Date

OCT 6 1943 19

S. J. LEWIS Scout

Trego

**KANSAS**

Map No. 70 Sec. 36 Twp. 12 R. 21W

Well No. 1 "A" Percy Gugler

Bridgeport Oil Company

**COMPLETED** Contractor

C W L SE SE

SECTION PLAT

\_\_\_\_\_ Ft. from N. Line

660 Ft. from S. Line

996 Ft. from E. Line

\_\_\_\_\_ Ft. from W. Line

			o

Ogallah Pool

Location \_\_\_\_\_

Rig up \_\_\_\_\_

Drilling and Remarks:

*Cu 3865*  
*5" @ 3865*  
*Pump 385 Pd*

*31 1/2 Gr*

RECORD

Cased \_\_\_\_\_ in., \_\_\_\_\_ ft.

Sand \_\_\_\_\_

Gas \_\_\_\_\_

Oil \_\_\_\_\_

Total Depth 3869

PRODUCTION

1st 24 hrs. Nat. \_\_\_\_\_

1st 24 hrs. after shot \_\_\_\_\_

Gas \_\_\_\_\_ Cu. Ft.

Dry Hole \_\_\_\_\_

Abandoned \_\_\_\_\_

Date

OCT 13 1943 19

S. J. LEWIS

Scout