


Barton County Kansas

Section 14 Township 17 Range 11W

Well No. 1 Bloomer "B"

Company Republic Nat. Gas

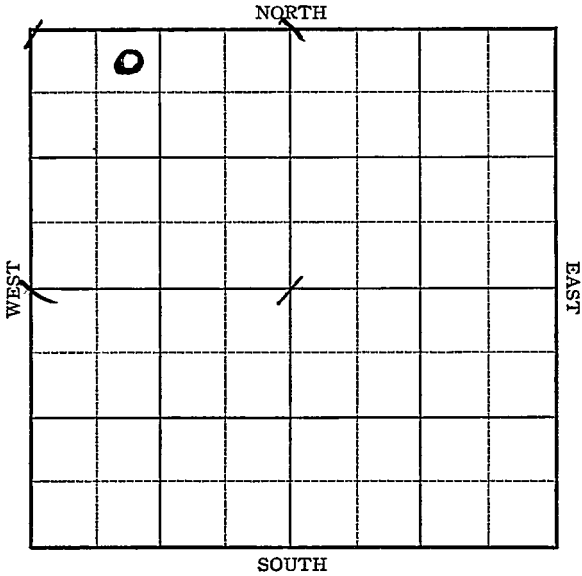

Sec. 14 Twp. 17 R. 11-W

Well No. #1-Bloomer "B" Farm


Republic Nat. Gas. Company

330 Ft. from N. Line

_____ Ft. from S. Line

_____ Ft. from E. Line

990 Ft. from W. Line

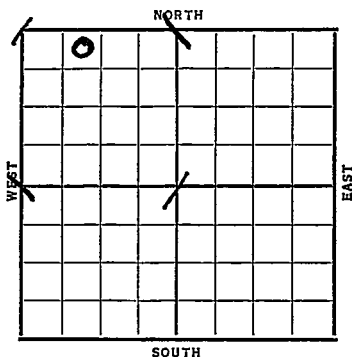

Date	REPORT
1937	
7/28	10" @ 216'. WOC.
8/6	Anhy 650'. Topeka 2625'. Drlg. 2840'.
8/16	Top Siliceous 3320 T.D. 3338' filled up 800 feet oil in 1 1/2 hours (Tel)
8/13	K.C. 3036'. Sil. 3320'. S.O. 3324'. T.D. 3326'. Rng. 7".
8/20	7" @ 3321'. T.D. 3338'. 2700' oil in 12 hrs.
8/25	7" @ 3321' Sil 3320' TD 3338' 1000 acid P.-219.75/4 187.6/4 Pot 1126
	COMPLETED

Barton **KANSAS**Map No. 55 Sec. 14 Twp. 17 R. 11 WWell No. 1 - Bloomer "B"Republic Nat. Gas Company

Contractor

FIRST REPORT

330 Ft. from N. Line14 Ft. from S. Line

_____ Ft. from E. Line

990 Ft. from W. Line

SECTION PLAT

0			

Location _____

Rig up _____

Drilling and Remarks:

10" 216 WOC

RECORD

Cased _____ in., _____ ft.

Sand _____

Gas _____

Oil _____

Total Depth _____

PRODUCTION

1st 24 hrs. Nat. _____

1st 24 hrs. after shot _____

Gas _____ Cu. Ft.

Dry Hole _____

Abandoned _____

Date

JUL 28 1937 19

H. D. Hatfield Scout

Barton **KANSAS**

Map No. _____ Sec. 14 Twp. 17 R. 11 ^W

Well No. 1 - Bloomer "B"

Republic Nat Gas Company
Contractor

COMPLETED

SECTION PLAT

330 Ft. from N. Line
____ Ft. from S. Line
____ Ft. from E. Line
990 Ft. from W. Line

0			

Location _____

Rig up _____

Drilling and Remarks:

1000 Acid
P. - 219.76/4
187.6/4
Pot - 1126

RECORD

Cased 7 in., 3321 ft.
Sand sil 3320
Gas _____
Oil _____
Total Depth 3338

PRODUCTION

1st 24 hrs. Nat. _____
1st 24 hrs. after shot _____
Gas _____ Cu. Ft.
Dry Hole _____
Abandoned _____

Date

AUG 25 1937 19

H. D. Hatfield, Scout