

Section 33 Township 25 Range 5 E

Well No. # 102 Stokes

Company Cities Service

NORTH

							0

WEST

EAST

SOUTH

Butler
25

KANSAS ✓

Sec. 33

Twp.

R.

5E

Well No. #102 Stokes Farm

Cities Service Company

B & R Drlg. - Contr. Contractor

..... Ft. from N. Line

500'


..... Ft. from S. Line

500'

..... Ft. from E. Line

..... Ft. from W. Line

SE SE SE

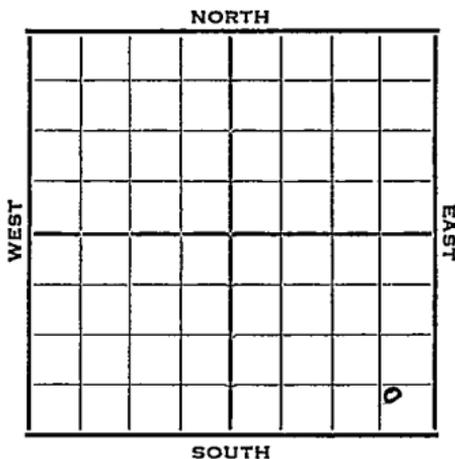

1952

Elev. 1352' REPORT

3/19

10" @ 77
Drlg. 2175'

6/25

Oil Well TD 2622
10" @ 77 Doug 1497
Lans. 1730 KC 2020
BKG 2170 Viola 2553
TD 3555 7" @ 2554 DD 2575
1000 A Simp 2585 DD 2622
20 qt/2585-2605
Comp. 20 bopd

COMPLETED

