

State Kansas County Stafford


Company GMR Oil Co. Well No. 1

Farm Dora Hahn

Survey _____

Block No. _____ Sec. 21 Twp. 22S Range 13W

Co-Ord. _____ Elev. 1903 R.B.

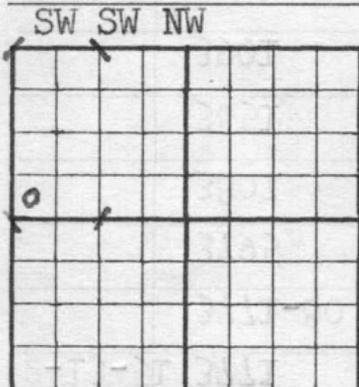

Wildcat
Stanolind
Lion
Rep. Nat.
British American F.O.

NOTE: Show Sketch of Lease and Well Location in Above Space

Ft. from N. Line

Ft. from S. Line

Ft. from W. Line

Ft. from E. Line

Date	Depth	
		SPD 2-2-51
2-3-51	300	8 5/8" @ 300' w/225 sx, 5 c.c.
2-5	1725	Drlg Anhydrite 758
2-6	2070	Drlg
2-7	2520	Drlg
2-8	2920	Drlg
2-10	3400	Drlg
	2988	Topeka
	3302	Heebner
	3428	Brn Lime

