


Map No. 1003 114 Sec. 34 Twp. 25 R. 5Well No. 17 BeemanBig 6 Oil Company

Contractor

NORTH

WEST

EAST

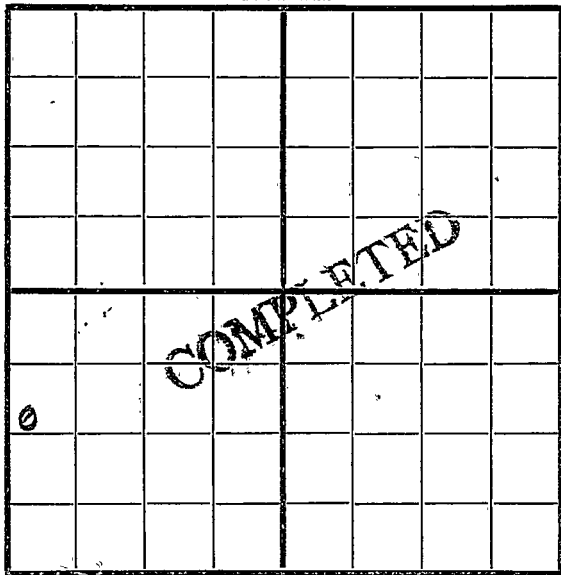

SOUTH

Location _____

Rig up _____

Drilling and Remarks:

40 bbls

RECORD

Cased _____ in., _____ ft.

Sand 1985-2015

Gas _____

Oil _____

Total Depth _____

PRODUCTION

1st 24 hrs. Nat. _____

1st 24 hrs. after shot _____

Gas _____ Cu. Ft.

Dry Hole _____

Abandoned _____

Date

7/16 - 8 1916Jyle Scout