

Butler


KANSAS

FORM 51 IOM 12-46 PETROL

Section 34 Township 25 Range 5E

Well No. 2 Fee

Company Eldorado Ref Co.

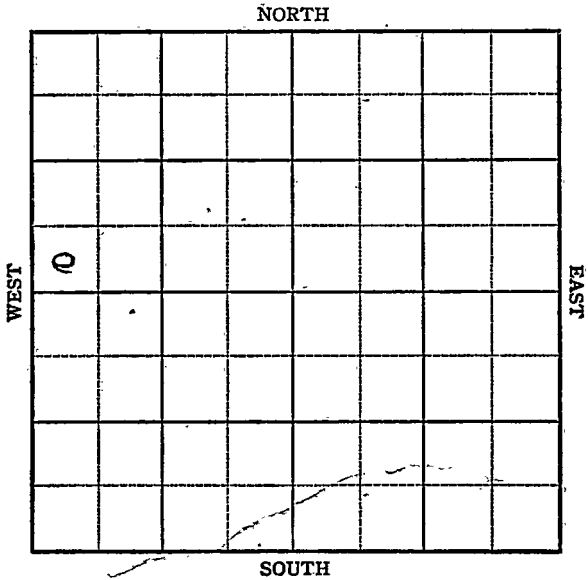

KANSAS

Butler county

Sec. 34 Twp. 25 R. 5E

Well No. 2 Fee Farm

Eldorado Ref. Company

Miscellaneous

 Ft. from N. Line


330

 Ft. from S. Line

 Ft. from E. Line

330

 Ft. from W. Line

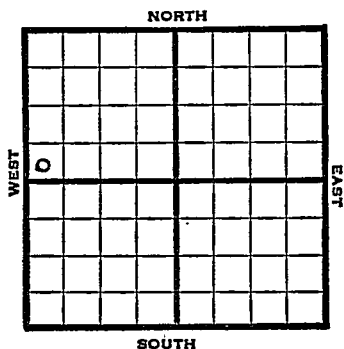

SW NW

1947

REPORT

5/28	Location
6/3	Mach.
6/10	"
6/17	15" @ 23' Drlg. 620'
6/24	Drlg. 1563' 12" @ 913'
7/1	8" @ 1715' Kansas City 1945' Drlg 2295'
7/8	Arb. 2395' 5" @ 2396' TD 2427' 1000 acid.
7/16	"
7/22	PB 2434 1500 acid
7/30	Arb. 2395' 5" @ 2396' 1500 Acid Pump 15 Pot 38.0 Gr. TD 2444'

COMPLETED

Map No. _____ Sec. 34 Twp. 25 R. 5E

Well No. 2 Fee

Eldorado Ref. Company

FIRST REPORT

Contractor

SW NW


SECTION PLAT

_____ Ft. from N. Line

330 Ft. from S. Line

_____ Ft. from E. Line

330 Ft. from W. Line

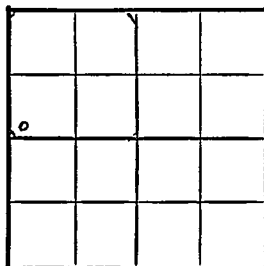

Butler County

Location X

Rig up _____

Drilling and Remarks:

RECORD

Cased _____ in, _____ ft.

Sand _____

Gas _____

Oil _____

Total Depth _____

PRODUCTION

1st 24 hrs. Nat. _____ *

1st 24 hrs. after shot _____

Gas _____ Cu. Ft.

Dry Hole _____

Abandoned _____

Date

MAY 28 1947

19

S. J. LEWIS

Scout

Map No. 14 ^{Kansas} Sec. 34 Twp. 25 R. 5E

Well No. 2 Fee

Eldorado Ref.


Company

COMPLETE

Contractor

SWNW

SECTION PLAT

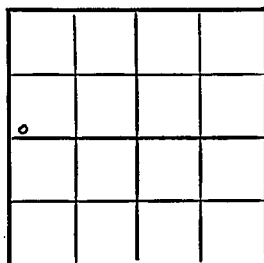

 Ft. from N. Line

330 Ft. from S. Line

 Ft. from E. Line

330 Ft. from W. Line

Butler County

Location

Rig up

Drilling and Remarks:

Cell 2395

5-102396

15000000

Pump 15 Bx

38-1/2

RECORD

Cased in., ft.

Sand

Gas

Oil

Total Depth 2447

PRODUCTION

1st 24 hrs. Nat.

1st 24 hrs. after shot

Gas Cu. Ft.

Dry Hole

Abandoned

Date

JUL 30 1947

19

S. J. LEWIS

Scout