


DX 78-1 Trego

**KANSAS**

Section 36 Township 12 Range 21W

Well No. #5 Gugler

Company CRA & Colo O & G

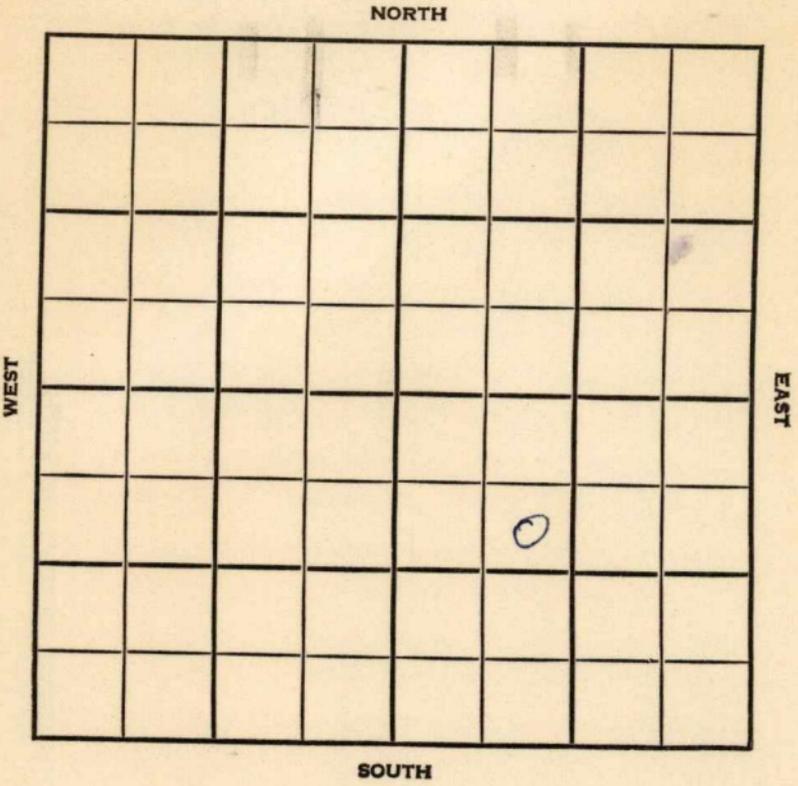

Trego

KANSAS


SEC. 36	TWP. 12	R. 21W
------------	------------	-----------

WELL NO. #5 Gugler FARM

COMPANY CRA & Colo. O&G

CONTRACTOR Hulme

\_\_\_\_\_ FT. FROM N. LINE  
 1550 FT. FROM S. LINE  
 1550 FT. FROM E. LINE  
 \_\_\_\_\_ FT. FROM W. LINE

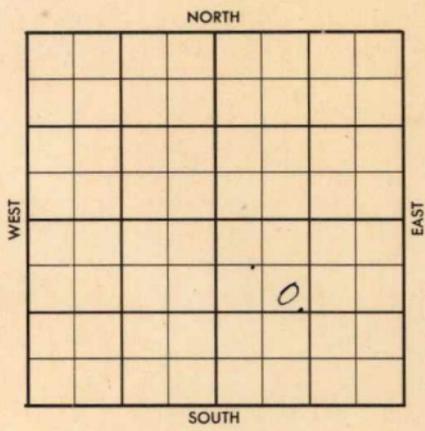

# SE NW SE

1956	ELEVATION 2213 DF, 2216 RB REPORT
------	--------------------------------------

7-11 8" @ 1571 w/750  
 Drlg. 2180'  
~~#####~~

8-8 DST 3800-25 op 1 hr., rec. 50' SW, 5' HOCMW, BHP 900/20".  
 DST 3867-74 op 1 hr, rec. 28' HOCM / 2' free oil, 485/20".  
 DST 3874-82 op 1 hr, ~~xxxx~~ 45' gas, rec. 300' oil, FP 0-115#, BHP 1150#/20"  
 5 1/2" @ 3868  
 CO 3882  
 B/ 5 boph, no/wtr.  
 FU 700' oil, 3 hrs.  
 P/ 45 BO, no/wtr., 12 hrs.  
 P/ 76 1/2 BO, no/wtr., 22 hrs.  
 P/ 83 BO no/wtr., 22 hrs.  
 P/ 99 BO, no/wtr., 22 hrs.  
 P/ 25 BOPD, no/wtr.

Anh. 1560'; Tp. 3238'; H. 3465';  
 Tr. 3486'; L. 3500'; BKC 3747';  
 Marm 3794'; A. 3866';  
 TD 3882'

COMPLETED

1 5

County Trego Elev. 2213 DF 2216RB  
 Sec. 36 Twp. 12 Rge. 21W  
 Company CRA & Colo. O & G  
 Farm Name Gugler No. 5

TOPS	DEPTH	LOG	DATUM	Loc. in Sec.
Anh.	1560			
Tr.				SE NW SE
H.				1550' SL
Tr.				1550' E L
Dg.				
Bl.				
L.				Geol.
K.C.				Contr.
B.K.C.				Hulme
Ce.				Pool
C.				
M.				
M.				
K.				
Mz.				
Mq.				
V.				
S.				
S.				
A				
R.				
PE.				
G.				
T.D.				

FIRST REPORT			
0			
JUL 11 '56			

Date Comm. 8<sup>th</sup> @ 1571/750 drlg. 2180

JUL 11 1956

R.G.

Co. Lse. No. Sec. T. R.

County Trego Elev. 2213 DF 2216 RI  
 Sec. 36 Twp. 19 Rgs. 21W  
 Company ORA & Colo. O & G  
 Farm Name Cugler No. 5

TOPS	DEPTH	LOG	DATUM	Loc. in Sec.
Anh.	560			SE NW S2
Tp.	3238			
H.	3465			1550' SL
Tr.	3486			
Dg.				1550' E L
Bl.				
L.	3500			Geol.
K.C.				Contr.
B.K.C.	3747			Hulme
Ge. <u>Macm</u>	3794			Pool
C.				
M.				
M.				
K.				
Mz.				
Mo.				
V.				
S.				
S.				
A.	3866			COMPLETE
R.				
PC.				
G.				
TD.	3882			

Date Comm. AUG 8 '56

8" @ 1571/750 drlc. 2180' JUL 18 '56  
 DST 3800-25 1hr net 50' SW  
 5' HOCMW BHP 900/20" DST  
 3867-74 1hr net 28' HOCM  
 +2' Free oil 485/20" DST  
 3874-82 1hr 450' gas net  
 300' oil FP 0-115 BHP 1150  
 120" 5 1/2 3868/ JUL 25 '56 co 3882 B  
 5 Boph net/w FU 700 oil 3hr

AUG 1 '55

POP P 45 B0 no/wt

12 hrs P. 76 1/2 B0 no/w

22 hrs AUG 8 '58 P. 83 B0 no/w

22 hrs P. 99 B0 no/w

22 hrs P. 25 B0 pd no/w