

KANSAS


Ellis

FORM 51 5M 4-41 PETROL

Section 4 Township 12 Range 17-W

Well No. #4 Dreiling

Company Deal Oil & Gas.

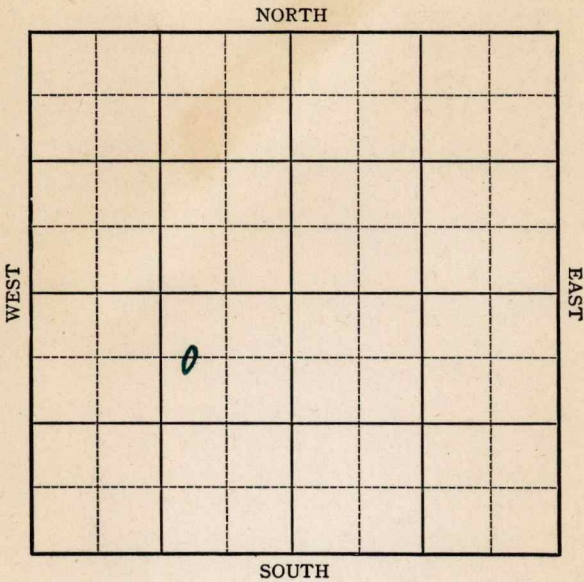


KANSAS

Ellis

Sec. 4 Twp. 12 R. 17-WWell No. #4 Dreiling FarmDeal Oil & Gas

Company

(Shutts)

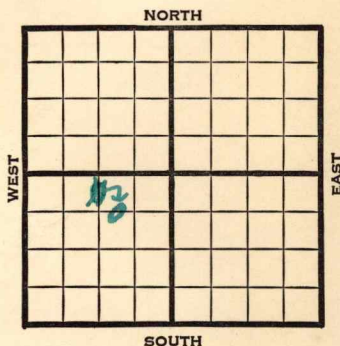~~330~~ 660 Ft. from N. Line Ft. from S. Line990 Ft. from E. Line~~1320~~ Ft. from W. Line

1941

REPORT

5/14

10" - 1348'

Anhy. 1360' Topeka 2124'

Lans. 3358' Drlg. 3635'

5/21

Cong. 3633'

No Arb.

T.D. 3700'

ABANDONED

Map No. 7/ Sec. 4 Twp. 12 R. 17WWell No. 4 Dreiling

Deal Oil & Gas

Company

FIRST REPORT

Contractor

SECTION PLAT

C N L SW

330

Ft. from N. Line

Ft. from S. Line

Ft. from E. Line

1320

Ft. from W. Line

SHUTTS POOL

Location

RECORD

Cased _____ in., _____ ft.

Sand _____

Gas _____

Oil _____

Total Depth _____

PRODUCTION

1st 24 hrs. Nat. _____

1st 24 hrs. after shot _____

Gas _____ Cu. Ft.

Dry Hole _____

Abandoned _____

Rig up _____

Drilling and Remarks:

10" - 1348

ANHY. 1360

Drlg. 3635

Topeka 2124

Lans. 3358

Date

MAY 14 1941

19

S. J. LEWIS Scout

Map No. 71 Sec. 4 Twp. 12 R. 17WWell No. 4 Dreiling

Deal Oil & Gas

Company

CORRECTION

Contractor

C W L NE SW

660 Ft. from N. Line Ft. from S. Line990 Ft. from E. Line Ft. from W. Line

SHUTTS POOL

SECTION PLAT

	o		

Location Rig up

Drilling and Remarks:

Well Abandoned

and reported

C N L SW

RECORD

Cased in., ft.Sand Gas Oil Total Depth

PRODUCTION

1st 24 hrs. Nat. 1st 24 hrs. after shot Gas Cu. Ft.Dry Hole Abandoned

Date

19

S. J. LEWIS

Scout

Map No. 71 Sec. 4 Twp. 12 R. 17WWell No. 4 Dreiling

Deal Oil & Gas

Company

Contractor

ABANDONED

SECTION PLAT

C N L SW

330 Ft. from N. Line

Ft. from S. Line

Ft. from E. Line

1320 Ft. from W. Line

SHUTTS POOL

Location

Rig up

Drilling and Remarks:

*Core 3633**No Cut.*

RECORD

Cased _____ in., _____ ft.

Sand _____

Gas _____

Oil _____

Total Depth 3700

PRODUCTION

1st 24 hrs. Nat. _____

1st 24 hrs. after shot _____

Gas _____ Cu. Ft.

Dry Hole _____

Abandoned _____

Date

MAY 21 1941

19

S. J. LEWIS Scout