


Section 14 Township 17 Range 11-W

Well No. #1 Stayder

Company Arms & Knight & Jacelyn

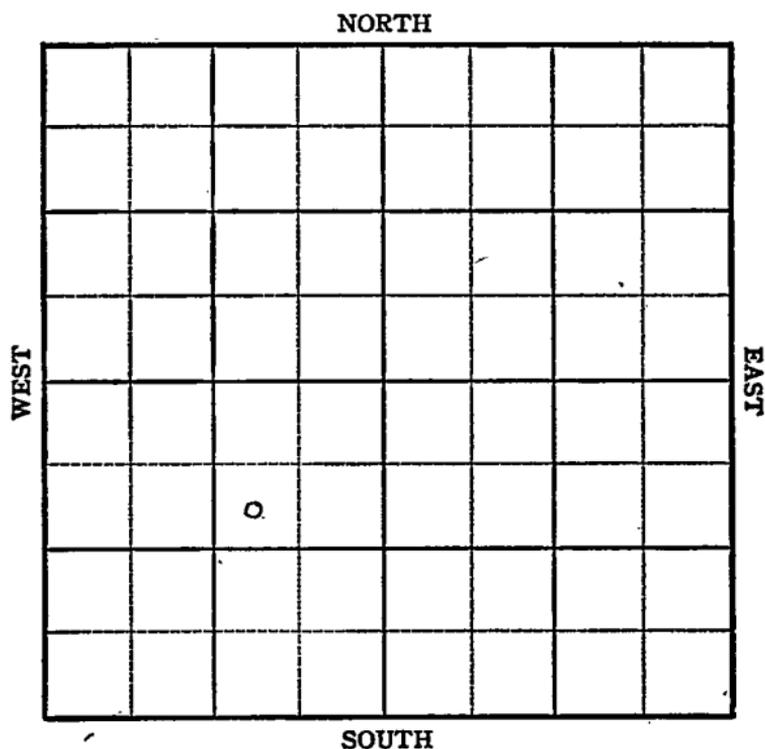

Sec. 14 Twp. 17 R. 11W ✓

Well No. #1 Stevder Farm

Arms & Knight & Jacelyn Company

Kraft Prusa


990' Ft. from N. Line

\_\_\_\_\_ Ft. from S. Line

990' Ft. from E. Line

\_\_\_\_\_ Ft. from W. Line

SW NE SW

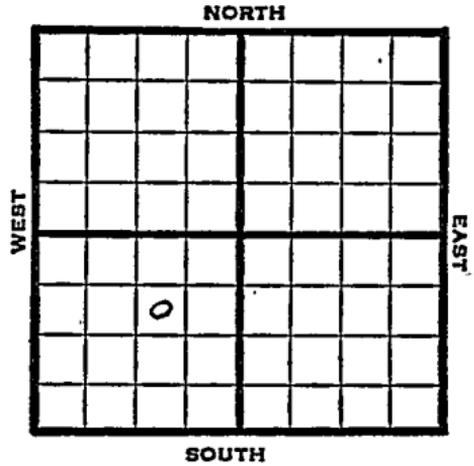

1950. **Elev 1859** **REPORT**

5/17 Spud 5-11-50  
 8" @ 233'  
 Anhy 650-95'  
 Drlg. 2645'

8/2 8" @ 233  
 Anhy 650-95 Top 2710  
 Lans 3018  
 TD 3301  
 5 1/2" @ 3297  
 Arb 3293  
 DD 3317  
 1000A CO to 3317  
 250A  
 Comp 104 bopd 6% wtr  
 Completed  
**COMPLETED**

Map No. \_\_\_\_\_ Sec. 14 Twp. 17 R. 11W

Well No. 1 Stewder

Arms & Knight & Jacelyn Company

\_\_\_\_\_ Contractor

SW NE SW

**SECTION PLAT**

990 Ft. from N. Line

\_\_\_\_\_ Ft. from S. Line

990 Ft. from E. Line

\_\_\_\_\_ Ft. from W. Line

<b>FIRST REPORT</b>			

Shell F. O.

Barton

Location \_\_\_\_\_

Rig up \_\_\_\_\_

**Drilling and Remarks:**

Spud 5-11-50  
 8" @ 233  
 Anhy. 650-95  
 Drlg. 2645

**RECORD**

Cased \_\_\_\_\_ in., \_\_\_\_\_ ft.  
 Sand \_\_\_\_\_  
 Gas \_\_\_\_\_  
 Oil \_\_\_\_\_  
 Total Depth \_\_\_\_\_

**PRODUCTION**

1st 24 hrs. Nat. \_\_\_\_\_  
 1st 24 hrs. after shot \_\_\_\_\_  
 Gas \_\_\_\_\_ Cu. Ft.  
 Dry Hole \_\_\_\_\_  
 Abandoned \_\_\_\_\_

Date

MAY 17 1950

**J. E. TYRA** Scout

