

# KANSAS

FORM 51 5M 10-41 PETROL


Barton

Section 14 Township 17 Range 11-W

Well No. #4 Bloomer "B"

Company Republic Natural Gas

Kraft Prusa Pool  
NORTH

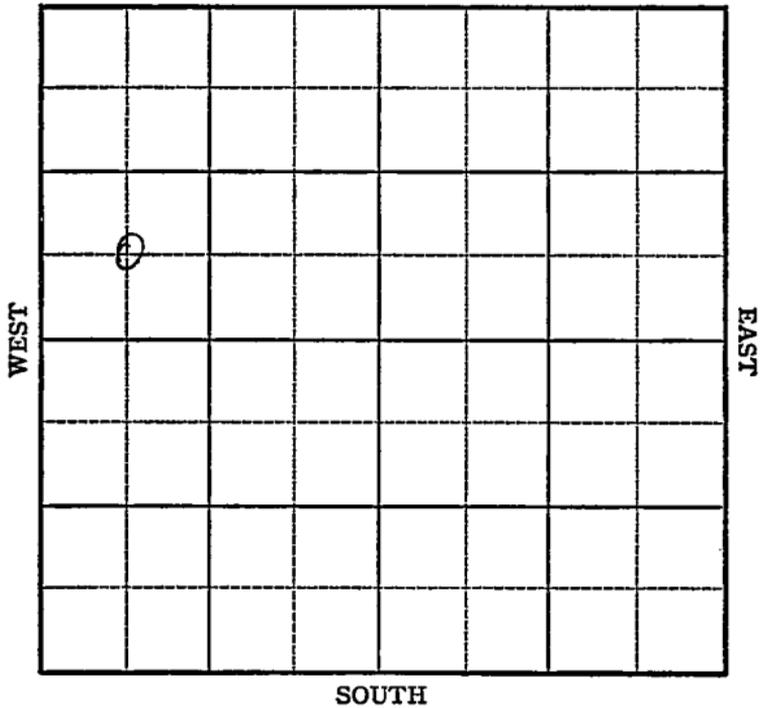

Sec. 14 Twp. 17 R. 11-W

Well No. #4 Bloomer "B" Farm

Republic Natural Gas Company

(Kraft Prusa Pool)


\_\_\_\_\_ Ft. from N. Line

660 Ft. from S. Line

\_\_\_\_\_ Ft. from E. Line

660 Ft. from W. Line

Elev. 1869

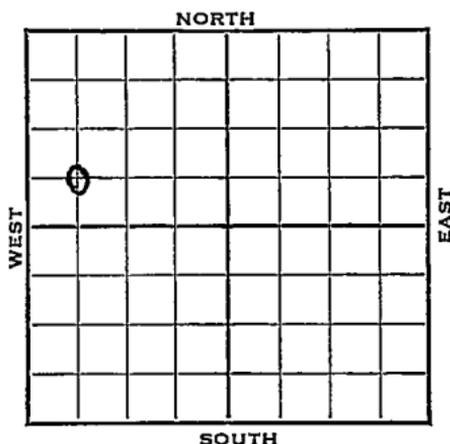

1942

REPORT

9/2 Location  
 9/9 8" @ 242 Drlg 2301  
 9/16 Arb 3300 5" @ 3300  
 TD 3307 Rust  
 9/23 TD 3316-1000 acid pump 16 oil per hr.  
 9/30 TD 3325 Tstg. Treated 2500 gals  
 Pump 22 boph 2% water.  
 10/7 " " "  
 10/14 Arb. 3300  
 5" - 3300  
 3500 acid  
 Pump 528 Pot.  
 Gravity 43.6  
 T.D. 3325

**COMPLETED**

Barton

KANSAS

Map No. 55 Sec. 14 Twp. 17 R. 11W

Well No. 4 Bloomer "B"

Republic Natural Gas Company

**FIRST REPORT**

Contractor

C SW NW

**SECTION PLAT**

\_\_\_\_\_ Ft. from N. Line

660 Ft. from S. Line

\_\_\_\_\_ Ft. from E. Line

660 Ft. from W. Line

D			

**KRAFT PRUSA POOL**

Location XXX

Rig up \_\_\_\_\_

Drilling and Remarks:

**RECORD**

Cased \_\_\_\_\_ in., \_\_\_\_\_ ft.

Sand \_\_\_\_\_

Gas \_\_\_\_\_

Oil \_\_\_\_\_

Total Depth \_\_\_\_\_

**PRODUCTION**

1st 24 hrs. Nat. \_\_\_\_\_

1st 24 hrs. after shot \_\_\_\_\_

Gas \_\_\_\_\_ Cu. Ft.

Dry Hole \_\_\_\_\_

Abandoned \_\_\_\_\_

Date

SEP 2 1942 19

S. J. LEWIS Scout

Map No: 55 Sec. 14 Twp. 17 R. 11W

Well No. 4 Blommer "B"

Republic Natural Gas Company

COMPLETED Contractor

C S W N W

SECTION PLAT

\_\_\_\_\_ Ft. from N. Line

660 Ft. from S. Line

\_\_\_\_\_ Ft. from E. Line

660 Ft. from W. Line

0			

KRAFT PRUSA POOL

Location \_\_\_\_\_

Rig up \_\_\_\_\_

Drilling and Remarks:

*Cr & 3300*  
*5" @ 3300*  
*3500 acid*  
*Pump 525 P.D.*  
  
*436 Gr*

RECORD

Cased \_\_\_\_\_ in., \_\_\_\_\_ ft.

Sand \_\_\_\_\_

Gas \_\_\_\_\_

Oil \_\_\_\_\_

Total Depth 3325

PRODUCTION

1st 24 hrs. Nat. \_\_\_\_\_

1st 24 hrs. after shot \_\_\_\_\_

Gas \_\_\_\_\_ Cu. Ft.

Dry Hole \_\_\_\_\_

Abandoned \_\_\_\_\_

Date

OCT 14 1942

19

S. J. LEWIS

Scout