


Section 14 Township 17 Range 11W

Well No. 6 Bloomer "B"

Company Republic Natural Gas

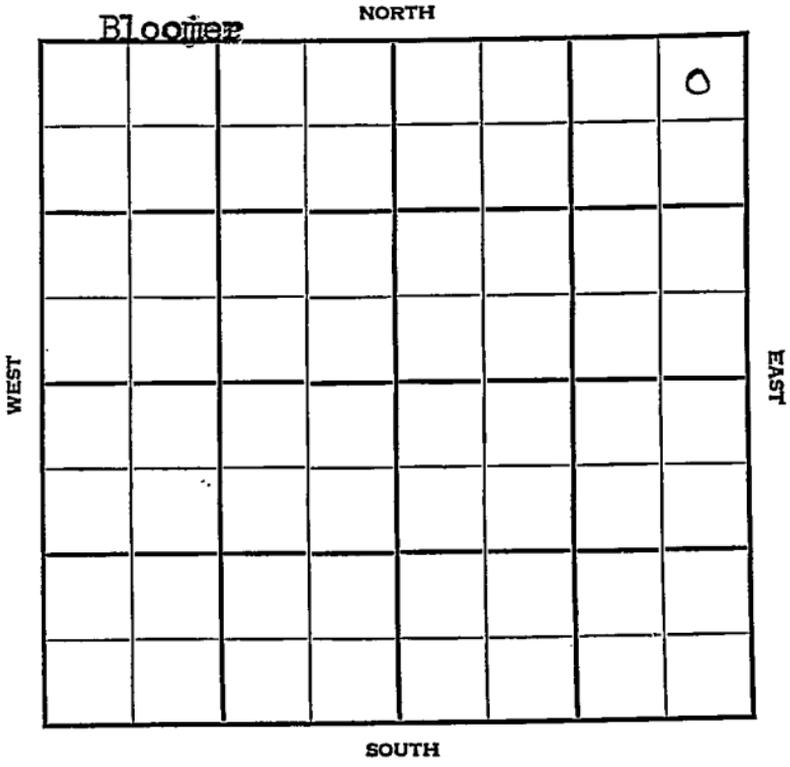

Sec. 14 Twp. 17 R. 11-W

Well No. #6 Bloomer "B" Farm

Republic Natural Gas Company

Bloomer Pool


330' Ft. from N. Line

\_\_\_\_\_ Ft. from S. Line

330' Ft. from E. Line

\_\_\_\_\_ Ft. from W. Line

NE/C

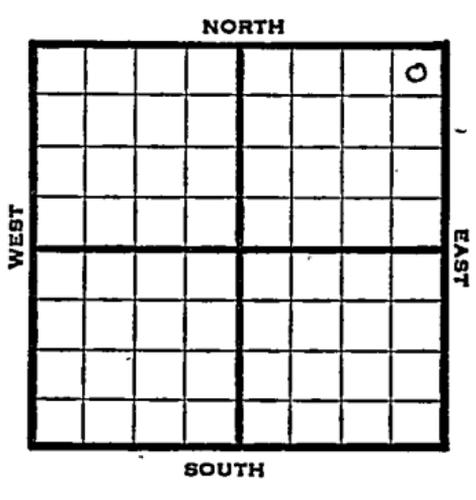

1947	Elev. 1889'	REPORT
11/12	10" @ 235'	
	Anhy. 670'	
	Lans. 3043'	
	Drlg. 3137'	
11/19	"	
11/25	Arbuckle 3330'	
	5" @ 3330'	
	TD 3343'	
	500 acid	
	Swb. 47 bbls. oil 1 hr.	
12/3	"	
12/10	"	
12/17	Arbuckle 3330'	
	5" @ 3330'	
	500 Acid	
	Pump 326 oil / 7% W	Pot
	TD 3343	
	Gravity 42	

**COMPLETED**

Map No. \_\_\_\_\_ Sec. 14 Twp. 17 R. 11W

Well No. 6 Bloomer "B"

Republic Natural Gas Company

**FIRST REPORT**

Contractor

NE/C

**SECTION PLAT**

330 Ft. from N. Line

\_\_\_\_\_ Ft. from S. Line

330 Ft. from E. Line

\_\_\_\_\_ Ft. from W. Line

			o

Barton County

Location \_\_\_\_\_

Rig up \_\_\_\_\_

Drilling and Remarks:

10" @ 235

anhy 670

Lans. 3043

drlg. 3137

**RECORD**

Cased \_\_\_\_\_ in., \_\_\_\_\_ ft.

Sand \_\_\_\_\_

Gas \_\_\_\_\_

Oil \_\_\_\_\_

Total Depth \_\_\_\_\_

**PRODUCTION**

1st 24 hrs. Nat. \_\_\_\_\_

1st 24 hrs. after shot \_\_\_\_\_

Gas \_\_\_\_\_ Cu. Ft.

Dry Hole \_\_\_\_\_

Abandoned \_\_\_\_\_

Date

NOV 1 2 1947

19

S. J. LEWIS

Scout

Map No. 55 Sec. 14 Twp. 17 R. 11W

Well No. 6 Bloomer "B"

Republic Natural Gas Company

**COMPLETE**

Contractor

NE/C

*E. J. 1889*  
**SECTION PLAT**

330 Ft. from N. Line

         Ft. from S. Line

330 Ft. from E. Line

         Ft. from W. Line

			0

Barton County

Location                                 

Rig up                                 

Drilling and Remarks:

*Per 330*  
*5" @ 330*  
*500 @ oil*  
*Pump 326 oil +*  
*590 W P.D.*  
*42 3/4*

**RECORD**

Cased          in.,          ft.

Sand                                 

Gas                                 

Oil                                 

Total Depth 334?

**PRODUCTION**

1st 24 hrs. Nat.                                 

1st 24 hrs. after shot                                 

Gas                                  Cu. Ft.

Dry Hole                                 

Abandoned                                 

Date

DEC 17 1947 19

S. J. LEWIS

Scout