


KANSAS Barton

Section 14 Township 17 Range 11W

Well No. 10 Bloomer "B"

Company Republic Natural Gas
Kraft-Prusa

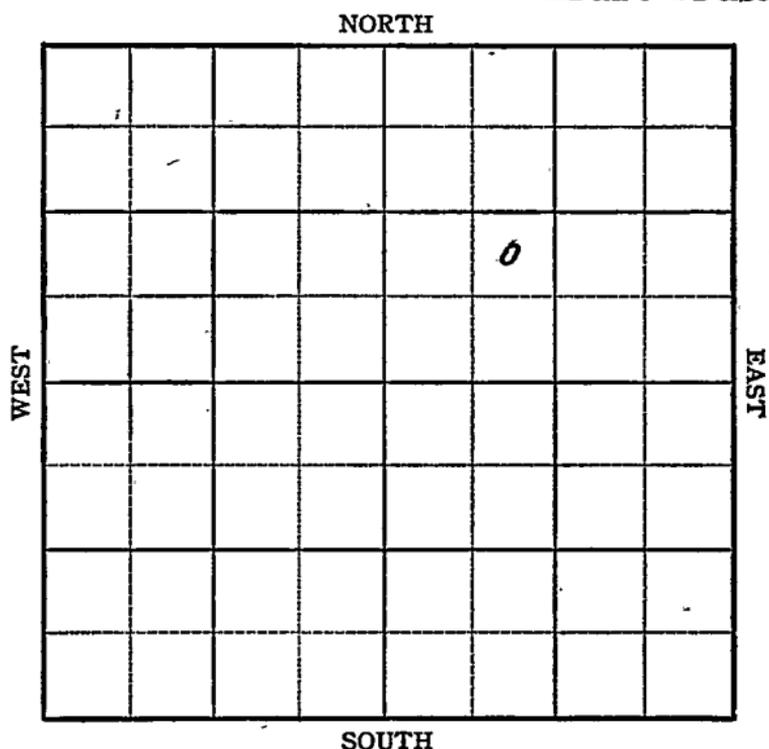

KANSAS

Barton

Sec. 14 Twp. 17 R. 11W ✓

Well No. #10 Bloomer "B" Farm

Republic Natural Gas Company

Kraft-Prusa


_____ Ft. from N. Line

990' Ft. from S. Line

_____ Ft. from E. Line

990' Ft. from W. Line

NE SW NE

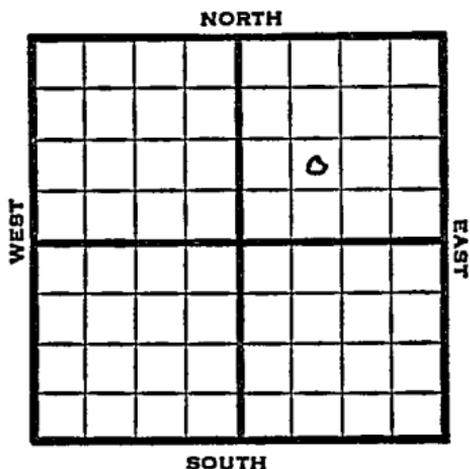

1949

Elev 1875

REPORT

4/6

10" @ 286'
 Drlg. 645'

4/12

Lansing 3015'
 Drlg 3090'

4/20

Arb. 3325
 7" @ 3327
 TD 3334
 500 acid
 Swb 28 bbls oil PH 4 hrs.

4/27

"

5/4

"

5/10

"

5/18

TD 3334'
 Arb. 3325'
 7" @ 3329'
 500 acid
 Echo Pot 1720 Oil
 424 Gr.
 Comp

COMPLETED

Map No. _____ Sec. 14 Twp. 17 R. 11W

Well No. 10 Bloomer "B"

Republic Natural Gas Company

FIRST REPORT

Contractor _____

NE SW NE

SECTION PLAT

_____ Ft. from N. Line

990 Ft. from S. Line

_____ Ft. from E. Line

990 Ft. from W. Line

		o	

Barton County

Location _____

Rig up _____

Drilling and Remarks:

10" @ 286

drlg. 645

RECORD

Cased _____ in., _____ ft.

Sand _____

Gas _____

Oil _____

Total Depth _____

PRODUCTION

1st 24 hrs. Nat. _____

1st 24 hrs. after shot _____

Gas _____ Cu. Ft.

Dry Hole _____

Abandoned _____

Date

APR 6 1949 19

S. J. LEWIS Scout

