

KANSAS


Barton

Section 14 Township 17 Range 11-W

Well No. #3 Bloomer "B"

Company Republic Natural Gas

NORTH Bloomer Pool

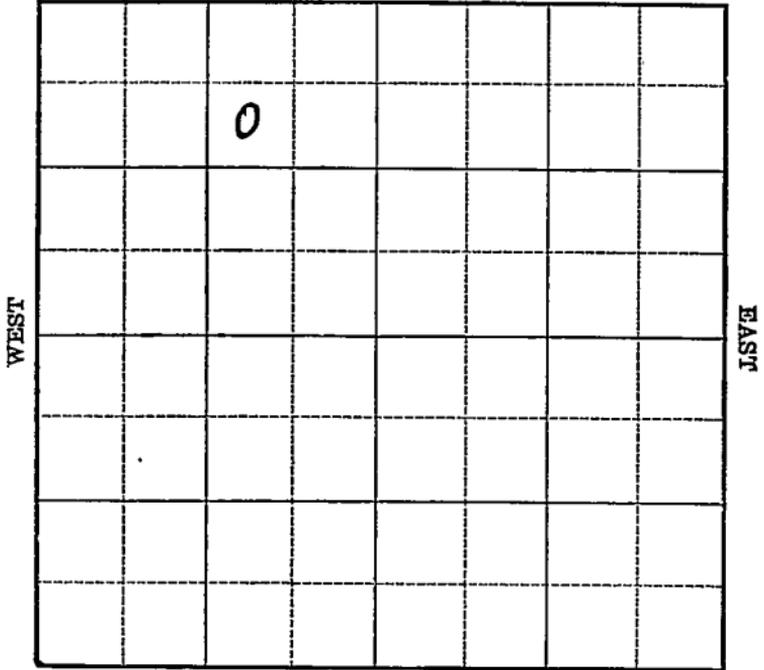

SOUTH

Sec. 14 Twp. 17 R. 11-W

Well No. #3 Bloomer "B" Farm

Republic Natural Gas Company

(Bloomer)


990 Ft. from N. Line

_____ Ft. from S. Line

990 Ft. from E. Line

_____ Ft. from W. Line

Elev. 1880

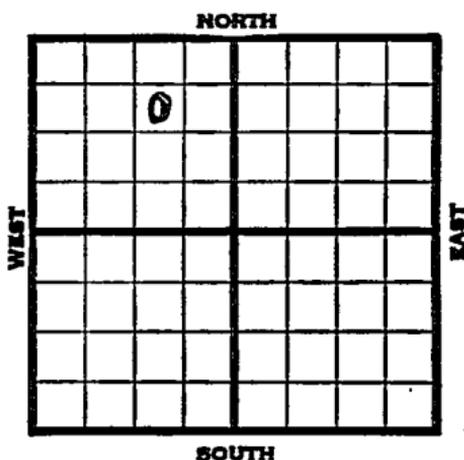

1940	REPORT
1/3	S. H.
1/11	10" - 180' Anhy 680'
	Drlg. 2140'
1/18	Lans. 3030' Drlg. 3175'
1/24	Arb. 3353'
	T.D. 3373'
	No shows.
	ABANDONED

Barton **KANSAS**

Map No. 55 Sec. 14 Twp. 17 R. 11W

Well No. 3 Bloomer "B"

Republic Natural Gas Company

Contractor

FIRST REPORT

SECTION PLAT

SW NE NW

990 Ft. from N. Line

_____ Ft. from S. Line

990 Ft. from E. Line

_____ Ft. from W. Line

	o		

BLOOMER POOL

Location _____

Rig up _____

Drilling and Remarks:

S. H.

RECORD

Cased _____ in., _____ ft.

Sand _____

Gas _____

Oil _____

Total Depth _____

PRODUCTION

1st 24 hrs. Nat. _____

1st 24 hrs. after shot _____

Gas _____ Cu. Ft.

Dry Hole _____

Abandoned _____

Date

Jan 5 1940

S. J. LEWIS Scout

Map No. 55 Sec. 14 Twp. 17 R. 11WWell No. 3 Bloomer "B"Republic Natural Gas Company

Contractor

ABANDONED

SECTION PLAT

SW NE NW

990 Ft. from N. Line Ft. from S. Line990 Ft. from E. Line Ft. from W. Line

BLOOMER POOL

	o		

Location _____

Rig up _____

Drilling and Remarks:

*As 83353**No shows*

RECORD

Cased _____ in., _____ ft.

Sand _____

Gas _____

Oil _____

Total Depth 3373

PRODUCTION

1st 24 hrs. Nat. _____

1st 24 hrs. after shot _____

Gas _____ Cu. Ft.

Dry Hole _____

Abandoned _____

Date

JAN 2 - 1940 19

S. J. LEWIS

Scout