

Sec. 14 Twp. 17 R. 11W

Well No. #8 Bloomer "B" Farm

Republic Natural Gas Company


Kraft-Prusa

990 Ft. from N. Line

_____ Ft. from S. Line

990 Ft. from E. Line

_____ Ft. from W. Line

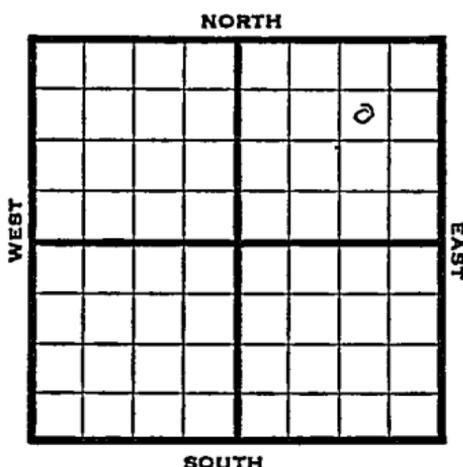

SW NE NE

1948 Elev. 1878' REPORT

- 4/14 Location
- 4/21 10" @ 279'
WOO
- 4/28 Drlg. 2685'
- 5/5 Arbuckle 3308-15'
TD 3315'
7" @ 3310'
RUST
- 5/12 TD 3326'
Swb 2 1/2 bbls oil PH, 15 hrs.
- 5/19 "
- 5/26 "
- 6/1 "
- 6/9 "
- 6/16 TD 3326'
Arb. 3308'
7" @ 3310' - 500 acid
Pump 195 0.1 Pot
4 3/4 Gr.
Comp.

COMPLETED

Map No. _____ Sec. 14 Twp. 17 R. 11WWell No. 8 Bloomer "B"Republic Natural Gas Company

FIRST REPORT

Contractor

SW NE NE

SECTION PLAT

			o

990 Ft. from N. Line

_____ Ft. from S. Line

990 Ft. from E. Line

_____ Ft. from W. Line

Barton County

Location X

Rig up _____

Drilling and Remarks:

RECORD

Cased _____ in., _____ ft.

Sand _____

Gas _____

Oil _____

Total Depth _____

PRODUCTION

1st 24 hrs. Nat. _____

1st 24 hrs. after shot _____

Gas _____ Cu. Ft.

Dry Hole _____

Abandoned _____

Date

APR 14 1948

19

S. J. LEWIS

Scout

