

Section 14 Township 17 Range 11W

Well No. 9 Bloomer "B"

Company Republic Natural Gas

**Bloomer**

NORTH

						0	

WEST

EAST

SOUTH

KANSAS

Barton

Sec. 14 Twp. 17 R. 11W ✓

Well No. #9 Bloomer "B" Farm \_\_\_\_\_

Republic Natural Gas Company

Bloomer Pool


\_\_\_\_\_ Ft. from N. Line

330' Ft. from S. Line

990' Ft. from E. Line

\_\_\_\_\_ Ft. from W. Line

SW SE NE

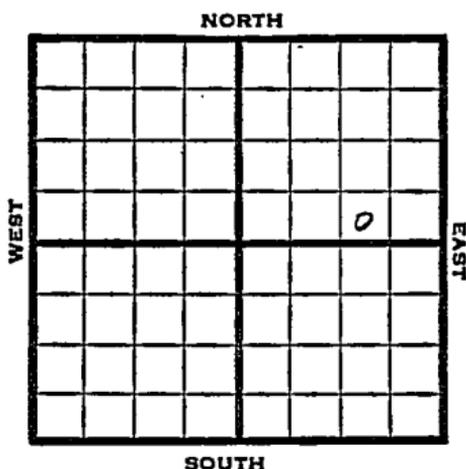

1949

Elev 1888'

REPORT

3/23

8" @ 304'  
Drlg. 1965'

3/30

Lansing 3035'  
A rb 3328-30

TD 3330'

7" @ 3328'

4/6

TD 3336  
1000 acid

4/12

TD 3338  
1500 acid  
Swb 6½ bbls oil PH 9 hrs.

4/20

"

4/27

"

5/4

TD 3338'  
Arb. 3328'  
7" @ 3328  
2500 acid  
Pump 169 Oil / 4% W Pot  
42° Gr.

Comp

**COMPLETED**

Kansas

Map No. \_\_\_\_\_ Sec. 14 Twp. 17 R. 11W

Well No. 9 Bloomer "B"

Republic Natural Gas Company

FIRST REPORT Contractor

SW SE NE

SECTION PLAT

\_\_\_\_\_ Ft. from N. Line

330 Ft. from S. Line

990 Ft. from E. Line

\_\_\_\_\_ Ft. from W. Line


Barton County

Location \_\_\_\_\_

Rig up \_\_\_\_\_

Drilling and Remarks:

8" @ 304

drlg. 1965

RECORD

Cased \_\_\_\_\_ in., \_\_\_\_\_ ft.

Sand \_\_\_\_\_

Gas \_\_\_\_\_

Oil \_\_\_\_\_

Total Depth \_\_\_\_\_

PRODUCTION

1st 24 hrs. Nat. \_\_\_\_\_

1st 24 hrs. after shot \_\_\_\_\_

Gas \_\_\_\_\_ Cu. Ft.

Dry Hole \_\_\_\_\_

Abandoned \_\_\_\_\_

Date

MAR 23 1949

S. J. LEWIS

Scout

