

# KANSAS

Barton

FORM 51 5M 4-41 PETROL


Section 15 Township 17 Range 11-W

Well No. #2 Peterman

Company Gulf

Kraft Prusa Pool .

NORTH

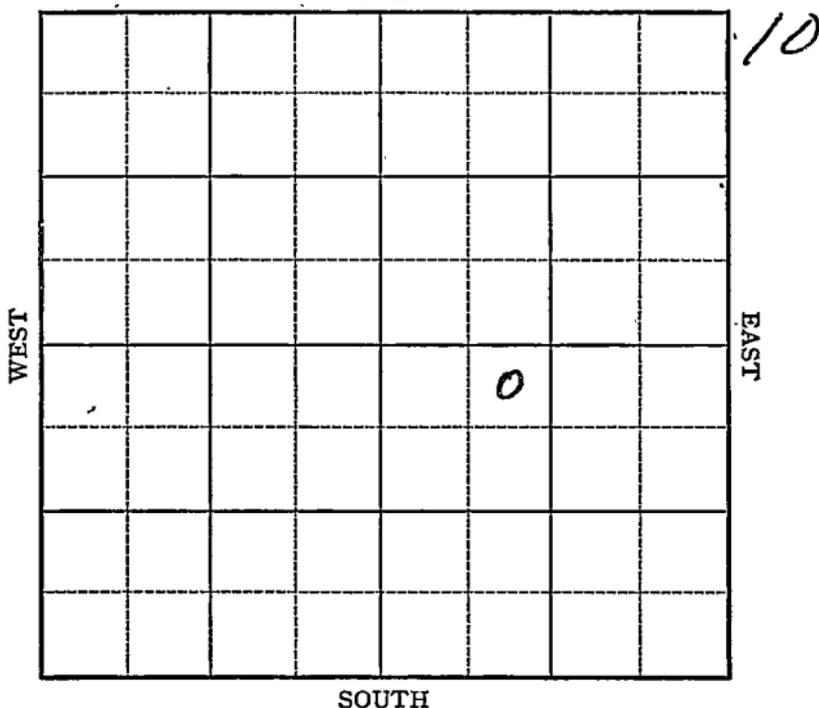

Sec. 15 Twp. 17 R. 11-W

Well No. #2 Peterman Farm

Gulf Company

(Kraft Prusa)


330 Ft. from N. Line

\_\_\_\_\_ Ft. from S. Line

\_\_\_\_\_ Ft. from E. Line

990 Ft. from W. Line

Elev. 1849

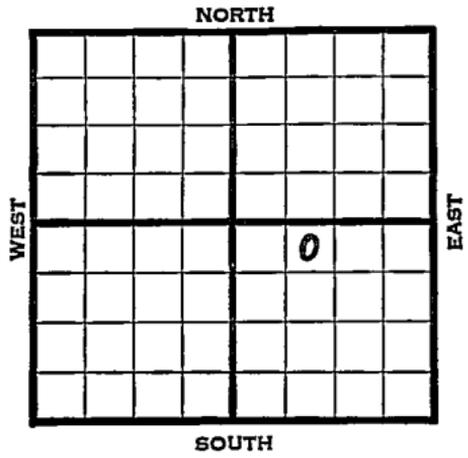

1942	REPORT
5/27	Cellar.
6/3	8" - 207' Drlg. 1745'
6/10	Lans. 3022' S.S.O. 3022-26, 3049-61. Arb. 3275-77 $\frac{1}{2}$ ' T.D. 5" - 3277' RUST.
6/17	T.D. 3306' 2650' oil.
6/24	Arb. 3275'
	5" - 3277'
	T.D. 3306'
	2000 acid.
	Sonic. potential 1147 bbls.
	42.4 Gravity
	<b>COMPLETED</b>

Barton KANSAS

Map No. 55 Sec. 15 Twp. 17 R. 11W

Well No. 2 Peterman

Gulf Company

**FIRST REPORT** Contractor

SECTION PLAT

NE NW SE

330 Ft. from N. Line

\_\_\_\_\_ Ft. from S. Line

\_\_\_\_\_ Ft. from E. Line

990 Ft. from W. Line

		o	

KRAFT PRUSA POOL

RECORD

Location \_\_\_\_\_

Cased \_\_\_\_\_ in., \_\_\_\_\_ ft.

Rig up \_\_\_\_\_

Sand \_\_\_\_\_

Drilling and Remarks:

Gas \_\_\_\_\_

Oil \_\_\_\_\_

Total Depth \_\_\_\_\_

Cellar

PRODUCTION

1st 24 hrs. Nat. \_\_\_\_\_

1st 24 hrs. after shot \_\_\_\_\_

Gas \_\_\_\_\_ Cu. Ft.

Dry Hole \_\_\_\_\_

Abandoned \_\_\_\_\_

Date

MAY 27 1942

19

S. J. LEWIS

Scout

Map No. 55 Sec. 15 Twp. 17 R. 11W

Well No. 2 Peterman

Gulf Company

**COMPLETED** Contractor

NE NW SE

SECTION PLAT

330 Ft. from N. Line

		0	

\_\_\_\_\_ Ft. from S. Line

\_\_\_\_\_ Ft. from E. Line

990 Ft. from W. Line

KRAFT PRUSA POOL

Location \_\_\_\_\_

Rig up \_\_\_\_\_

Drilling and Remarks:

*CR 3275*

*5" @ 3277*

*2000 acid*

*Sonic Prod. 1147*

*42 4/8*

RECORD

Cased \_\_\_\_\_ in., \_\_\_\_\_ ft.

Sand \_\_\_\_\_

Gas \_\_\_\_\_

Oil \_\_\_\_\_

Total Depth 3306

PRODUCTION

1st 24 hrs. Nat. \_\_\_\_\_

1st 24 hrs. after shot \_\_\_\_\_

Gas \_\_\_\_\_ Cu. Ft.

Dry Hole \_\_\_\_\_

Abandoned \_\_\_\_\_

Date

JUN 24 1942 19

S. J. LEWIS Scout