

KANSAS


Section 15 Township 17 Range 11W

Well No. 3 Barth

Company Shell

Kraft-Prusa Pool
NORTH

12

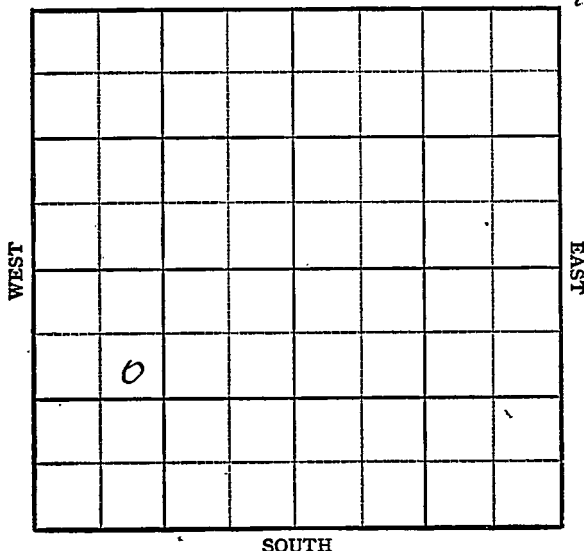

Sec. 15 Twp. 17 R. 11-W ✓

Well No. #3 Barth Farm

Shell Company

Kraft-Prusa Pool


990 Ft. from N. Line

Ft. from S. Line

Ft. from E. Line

990 Ft. from W. Line

SE NW SW

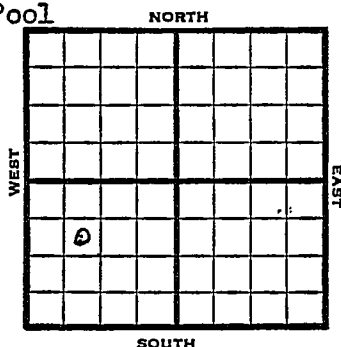

1948

Eli 1818'

R E P O R T

9/29

Location

10/6

Drlg 1360'

10/13

Topeka 2611'

Drlg 2926'

10/19

Lansing 2986'

Arb. 3254-62'

TD 3262'

4"@ 3255

2800' fluid

10/26

Pump 47 oil / 52 % W in 7 hrs.

11/3

"

11/10

TD 3262'

Arb. 3254'

4"@ 3255'

Pump 340 Oil / 80% W Pot

42° Gr.

Comp

COMPLETED

Map No. _____ Sec. 15 Twp. 17 R. 11WWell No. 3 Barth

_____ Shell _____ Company

_____ FIRST REPORT _____ Contractor


SE NW SW

SECTION PLAT

990 Ft. from N. Line

_____ Ft. from S. Line

_____ Ft. from E. Line

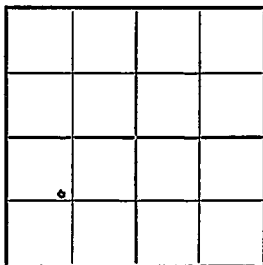990 Ft. from W. LineBarton CountyLocation X

Rig up _____

Drilling and Remarks:

RECORD

Cased _____ in., _____ ft.

Sand _____

Gas _____

Oil _____

Total Depth _____

PRODUCTION

1st 24 hrs. Nat. _____

1st 24 hrs. after shot _____

Gas _____ Cu. Ft.

Dry Hole _____

Abandoned _____

Date

SEP 29 1948 19S. J. LEWIS

Scout

Kansas

Map No. 55 Sec. 15 Twp. 17 R. 11WWell No. 3 Barth


Shell

Company

COMPLETE

Contractor

SE NW SW

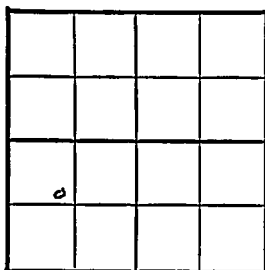E 11778
SECTION PLAT990 Ft. from N. Line Ft. from S. Line Ft. from E. Line990 Ft. from W. Line

Barton County

Location

Rig up

Drilling and Remarks:

*Cr 8254**4" Q3205**Run 840 in 6 ft
80% W B. &.**42° E*

RECORD

Cased in., ft.Sand Gas Oil ☒Total Depth 2262

PRODUCTION

1st 24 hrs. Nat. 1st 24 hrs. after shot Gas Cu. Ft.Dry Hole Abandoned

Date

NOV 10 1948

19

S. J. LEWIS

Scout