


Section 15 Township 17 Range 11W

Well No. 4 Herthel

Company Shell

Kraft-Prusa Pool  
NORTH

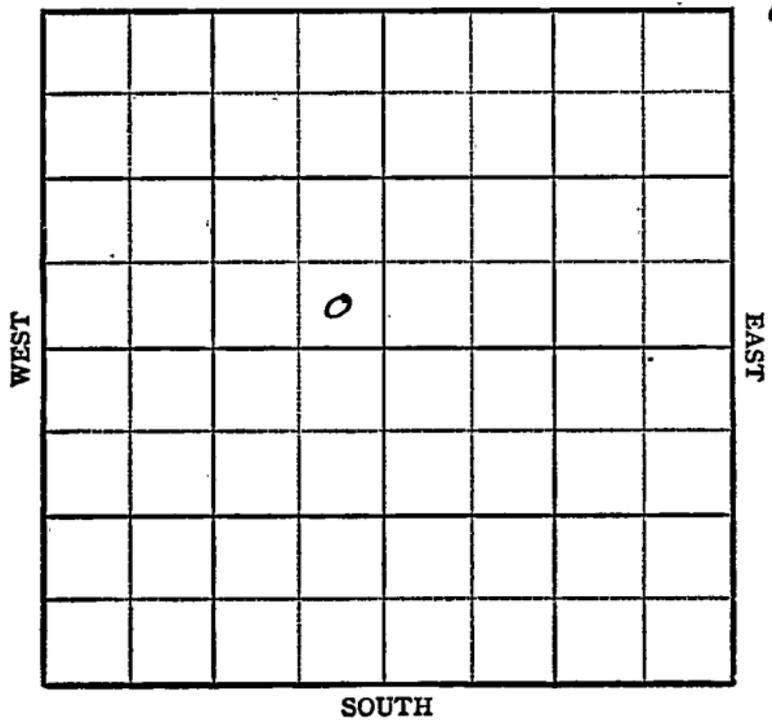

**KANSAS**

Barton

Sec. 15 Twp. 17 R. 11W ✓

Well No. #4 Herthel Farm \_\_\_\_\_

Shell Company

Kraft-Prusa Pool


\_\_\_\_\_ Ft. from N. Line

330' Ft. from S. Line

330' Ft. from E. Line

\_\_\_\_\_ Ft. from W. Line

SE NW

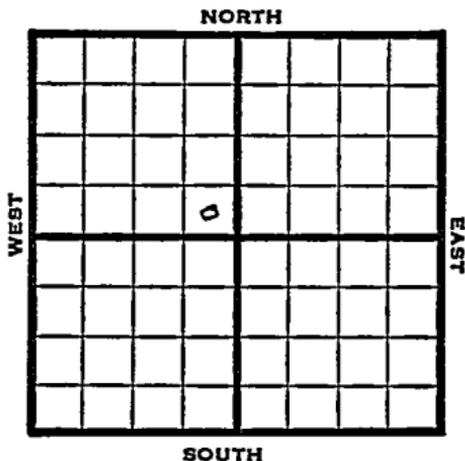

1948 **REPORT**

Eli 1843'

11/23 8" @ 365'  
 11/30 Drlg 2905'  
 12/8 Lansing 3008'  
 Arb 3268'  
 4" @ 3269'  
 TD 3283'  
 3000 oil 12 hrs.  
 12/15 TD 3283'  
 Arb. 3268'  
 4" @ 3269'  
 Pump 1082 Oil Pot  
 42° Gr.  
 Comp  
**COMPLETED**

Map No. \_\_\_\_\_ Sec. 15 Twp. 17 R. 11W

Well No. 4 Herthel

Shell Company

FIRST REPORT Contractor

SE NW

SECTION PLAT

\_\_\_\_\_ Ft. from N. Line

330 Ft. from S. Line

330 Ft. from E. Line

\_\_\_\_\_ Ft. from W. Line


Barton County

Location \_\_\_\_\_

Rig up \_\_\_\_\_

Drilling and Remarks:

8" @ 365

RECORD

Cased \_\_\_\_\_ in., \_\_\_\_\_ ft.

Sand \_\_\_\_\_

Gas \_\_\_\_\_

Oil \_\_\_\_\_

Total Depth \_\_\_\_\_

PRODUCTION

1st 24 hrs. Nat. \_\_\_\_\_

1st 24 hrs. after shot \_\_\_\_\_

Gas \_\_\_\_\_ Cu. Ft.

Dry Hole \_\_\_\_\_

Abandoned \_\_\_\_\_

Date

NOV 23 1948 19

S. J. LEWIS Scout



# O.W.W.O.

FORM 513 SUNRAY

County Barton Elev. 1813  
 Sec. 15 Twp. 17 Rgs. 11W  
 Company Shell Oil  
 Farm Name E. J. Herthel No. 4

TOPS	DEPTH	LOG	DATUM	Loc. in Sec.
Anh.				SE SE NW <b>O.W.W.O.</b>
TP.	2632			
H.				
Tr.				
Dg.				Geo. <u>O.W.W.O.</u> Contr.
Bl.				
L.	3002			Pool <u>Kraft-Prusa</u>  FIRST REPORT FEB 13 '57  COMPLETE
K.C.				
B.K.C.				
Ce.				
C.				
M.				
M.				
K.				
Mz.				
Ma.				
V.				
S.				
S.				
A.	3268			
R.				
PE.				
G.				
T.D.				

Date Comm.

1st @ 3269 OTD 3283 PB 3112

16/ 3037-13 20/ 3020-25 20/ 3011-16

1500 A F/ 77 bo 6 hr. P/ 109 bo 13 hr.

P/ 58 bo 2 1/2 hr. Comp. 11 bond 2 bw

13