

KANSAS


FORM 51 5M PETROL

Barton

Section 15 Township 17 Range 11-W

Well No. 4 Peterman

Company Gulf

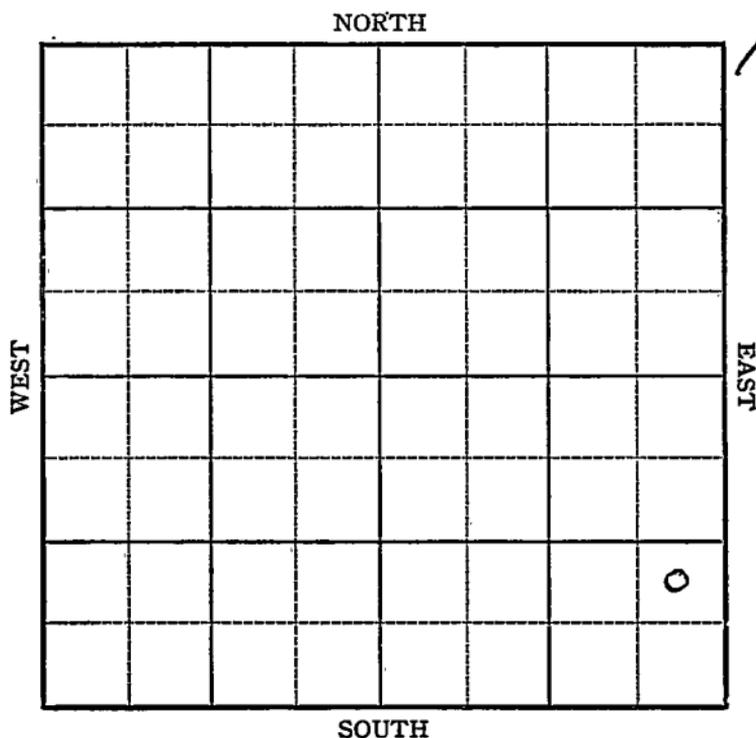


Sec. 15 Twp. 17 R. 11-W

Well No. #4 Peterman Farm

Gulf Company

NORTH

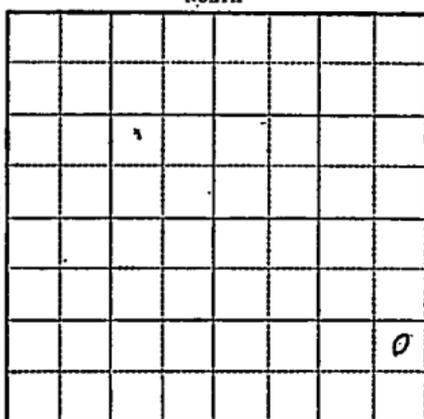

\_\_\_\_\_ Ft. from N. Line

1090 Ft. from S. Line

330 Ft. from E. Line

\_\_\_\_\_ Ft. from W. Line

*Elev. 1846*

1943

, R E P O R T

11/3

Rotary

11/10

8" @ 206  
Drlg. 820'

11/17

Drlg. 2613'

11/24

Arb 3287  
TD 3289 1/2 PO  
5" @ 3288

RUST

12/1

TD 330 2800' oil 8 hrs.

12/8

5" @ 3285  
Arb 3284  
2000 acid  
Sonic-meter Pot 4596  
T.D. 3300  
Max 3000  
Gravity 42.2

COMPLETED

KANSAS

Map No. 55 Sec. 15 Twp. 17 R. 11WWell No. 4 Peterman

Gulf

Company

FIRST REPORT

Contractor

NE SE SE

SECTION PLAT

         Ft. from N. Line1090 Ft. from S. Line330 Ft. from E. Line         Ft. from W. Line

			o

Kraft Prusa Pool

Location                                 Rig up                                 

Drilling and Remarks:

Rotary

RECORD

Cased          in.          ft.Sand                                 Gas                                 Oil                                 Total Depth                         

PRODUCTION

1st 24 hrs. Nat.                         1st 24 hrs. after shot                         Gas                          Cu. Ft.Dry Hole                                 Abandoned                                 

Date

NOV 3 1943 19

S. J. LEWIS Scout

