



Sec. 15 Twp. 17 R. 11W

Well No. #4 Soeken "A" Farm

Shell Company

Contractor

Kraft Prusa

Ft. from N. Line

330'


Ft. from S. Line

990'

Ft. from E. Line

Ft. from W. Line

SW SE SW

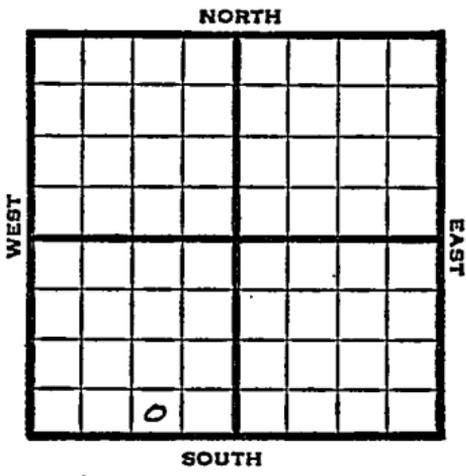

1950

Elev 1848'

REPORT

$\frac{3}{8}$   
 $\frac{4}{5}$

Location

TD 3349'

10" @ 356'

7" @ 3348'

Lans 3013'

Arb 3273'

3000 BOPD

Comp

**COMPLETED**

Map No. \_\_\_\_\_ Sec. 15 Twp. 17 R. 11W

Well No. 4 Soeken "A"

Shell Company

Contractor

SW SE SW

**SECTION PLAT**

\_\_\_\_\_ Ft. from N. Line

330 Ft. from S. Line

990 Ft. from E. Line

\_\_\_\_\_ Ft. from W. Line



Barton County

Location X

Rig up \_\_\_\_\_

Drilling and Remarks:

**RECORD**

Cased \_\_\_\_\_ in., \_\_\_\_\_ ft.

Sand \_\_\_\_\_

Gas \_\_\_\_\_

Oil \_\_\_\_\_

Total Depth \_\_\_\_\_

**PRODUCTION**

1st 24 hrs. Nat. \_\_\_\_\_

1st 24 hrs. after shot \_\_\_\_\_

Gas \_\_\_\_\_ Cu. Ft.

Dry Hole \_\_\_\_\_

Abandoned \_\_\_\_\_

Date

MAR 8 1950

19

J. E. TYRA S

Map No. \_\_\_\_\_ Sec. <sup>Kansas</sup> 15 Twp. 17 R. 11W

Well No. 4 Soeken "A"

Shell \_\_\_\_\_ Company

\_\_\_\_\_ Contractor

SW SE SW


*E.I. 1848*  
SECTION PLAT

\_\_\_\_\_ Ft. from N. Line

330 Ft. from S. Line

990 Ft. from E. Line

\_\_\_\_\_ Ft. from W. Line

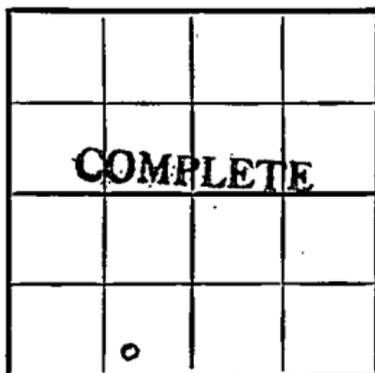

Barton County

Location \_\_\_\_\_

Rig up \_\_\_\_\_

Drilling and Remarks:

*10" @ 356*  
*7" @ 3348*  
*Lens 3013.*  
*arb 3273*  
*3600 BOPD*

RECORD

Cased \_\_\_\_\_ in., \_\_\_\_\_ ft.

Sand \_\_\_\_\_

Gas \_\_\_\_\_

Oil \_\_\_\_\_

Total Depth *3349*

PRODUCTION

1st 24 hrs. Nat. \_\_\_\_\_

1st 24 hrs. after shot " " \_\_\_\_\_

Gas \_\_\_\_\_ Cu. Ft.

Dry Hole \_\_\_\_\_

Abandoned \_\_\_\_\_

Date

APR 5 1950 19

J. E. TYRA  
Scout