


Barton

KANSAS

Section 15 Township 17 Range 11 W

Well No. # 5 Herthel

Company Shell Oil

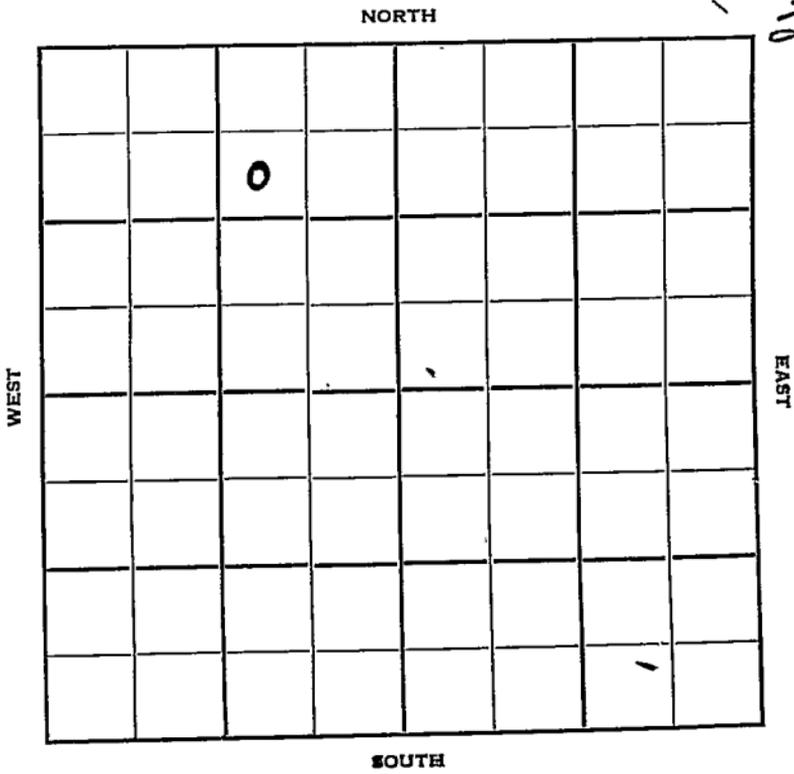

Sec. 15 Twp. 17 R.

Well No. # 5 Herthel Farm

Shell Oil Company


B & R Drlg. Contractor

1037 Ft. from N. Line

Ft. from S. Line

986 Ft. from E. Line

Ft. from W. Line

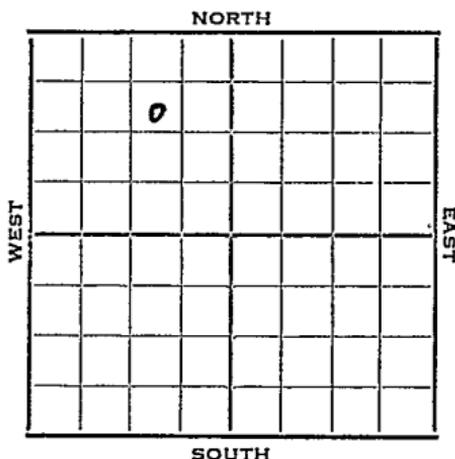

SW NE NW

1952

Elev. 1828' REPORT

4/30

Location

5/7

10" @ 380'

Drlg. 2189'

5/14

Tarkio 2330

Topeka 2626

Lans. 2998

Arb. 3278

RTD 3280 Seal 5" @

5/21

7" @ 3279' DP 3280' B/SSW & O

250 A no help. DD 3282' 1 BA

SSO & AW 250 A

5/28

S/ 6 Boph for 10 hrs.

6/11

Spud 4-30-52

Oil Well TD. 3282

10" @ 380

Tarkio 2330

Top 2626

Lans. 2998

Arb. 3278

TD 3280

7" @ 3279

DP to 3280

B/SSW & O

250 A

DD 3282

SSO & AW

250A

S/6 boph

Comp. 127 bopd

COMPLETED

County Barton State Kansas

Sec. 15 (Blk. Twp.) 17 (Sur. Rge.) 11W Map No.

Operator Shell Oil

Well No. 5 Farm Hertzel

Elev. _____ Location SW NE NW

1037 Ft. From N Line NW

986 Ft. From E Line Quarter

Ist. Report APR 30 1952

Completion _____

Remarks _____

B & R Drlg. - Contr.

Spudding Date _____

Drlg. Data _____

Location

J. G. McGEHEE

County Barton State Kansas

Sec. 15 (Blk. Twp.) 17 (Sur. Rge.) 11W Map No.

Operator Shell Oil

Well No. 5 Farm Herthel

Elev. 1828 Location SW NE NW

1037Ft. From N Line NW
986Ft. From E Line Quarter

Ist. Report

Completion JUN 11 1952

Remarks

B & R Drlg. - Contr.

Spudding Date 4-30-52

Drlg. Data Oil well TD 3282

10" @ 380 Tarkio 2330 Top. 2626

Lans. 2998 Arb. 3278 TD 3280

7" @ 3279 DP to 3280 B/ SSW & O

250 A DD 3282 SSO & AW 250 A

S/ 6 boph^e Comp. 127 bopd