

KANSAS


FORM 51 5M 11-44 PETROL

Barton County

Section 15 , Township 17 Range 11W

Well No. #5 Peterman

Company Gulf

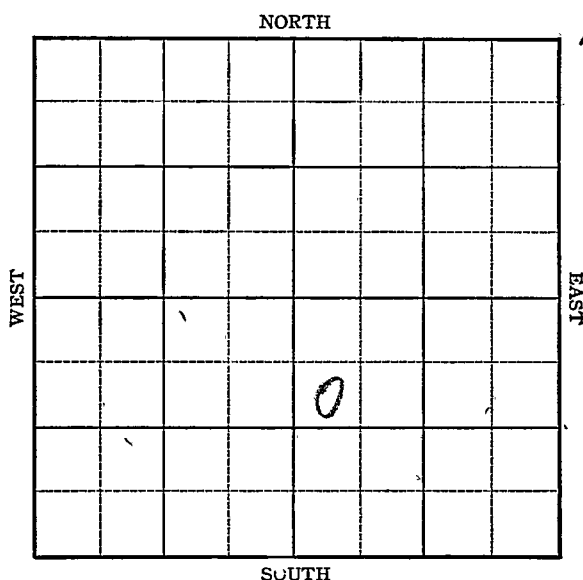


Sec. 15 Twp. 17 R. 11WWell No. #5 Peterman FarmGulf Company

Kraft-Prusa

990 Ft. from N. Line Ft. from S. Line Ft. from E. Line330 Ft. from W. Line

SW NW SE

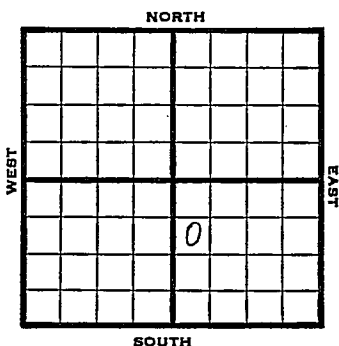

1946 Elev. 1836' REPORT

2/13	8" @ 257 Drlg. 1570'
2/21	Drlg. 3186'
2/28	Lans. 3012' Cong. 3265' Arb. 3325' Granite 3574' T.D. 3584' Run 5". S.W.D.
3/7	5" - 3410' T.D. 3417' 3000 acid.
3/14	" "
3/21	" "
3/28	" "
3/7	- -
4/4	" "
4/10	" "
4/16	" - " -
4/23	" "
5/1	" "
5/7	" "
5/14	" "
5/22	Arb. 3325 Granite 3574 5" @ 3410 TD 3584 3000 acid. SWD

ABANDONED

KANSAS Kansas Pool Name Kraft-PrusaMap No. 55 Sec. 15 Twp. 17 R. 11WWell No. 5 PetermanGulf CompanyFIRST REPORT Contractor

SW NW SE

990 Ft. from N. Line Ft. from S. Line Ft. from E. Line330 Ft. from W. Line

SECTION PLAT

Barton CountyLocation Rig up

Drilling and Remarks:

8"-2571570

RECORD

Cased in., ft.Sand Gas Oil Total Depth

PRODUCTION

1st 24 hrs. Nat. 1st 24 hrs. after shot Gas Cu. Ft.Dry Hole Abandoned

Date

FEB 13 194619S. J. LEWIS Scout

KANSAS

Kansas Pool Name Kraft-PrusaMap No. 55 Sec. 15 Twp. 17 R. 11WWell No. 5 PetermanGulf

Company

ABANDONED

Contractor

SW NW SE

E11836
SECTION PLAT

		0	

990 Ft. from N. Line Ft. from S. Line Ft. from E. Line330 Ft. from W. LineBarton CountyLocation Rig up

Drilling and Remarks:

Per 2325
Granite 2357.4
5 23418.
3000 acid
SWR

RECORD

Cased in., ft.Sand Gas Oil Total Depth 3574

PRODUCTION

1st 24 hrs. Nat. 1st 24 hrs. after shot Gas Cu. Ft.Dry Hole Abandoned

Date

MAY 22 1946

19

S. J. LEWIS

Scout