


Section 15 Township 17 Range 11W

Well No. #7 Peterman

Company Gulf Oil

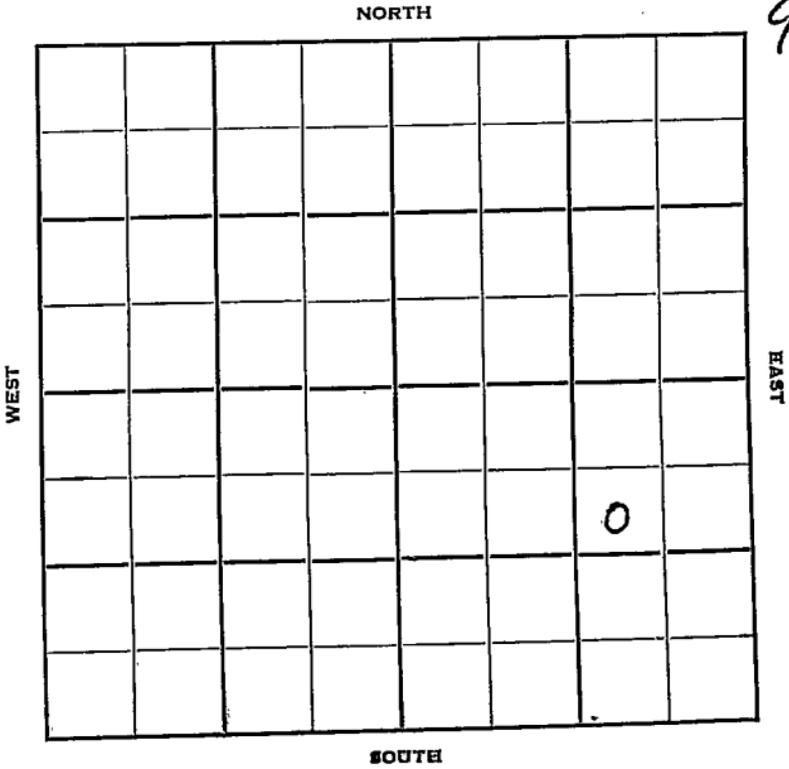

Sec. 15 Twp. 17 R. 11W

Well No. #7 Peterman Farm

Gulf Oil Company

Contractor


Ft. from N. Line

1650 Ft. from S. Line

990 Ft. from E. Line

Ft. from W. Line

SW NE SE

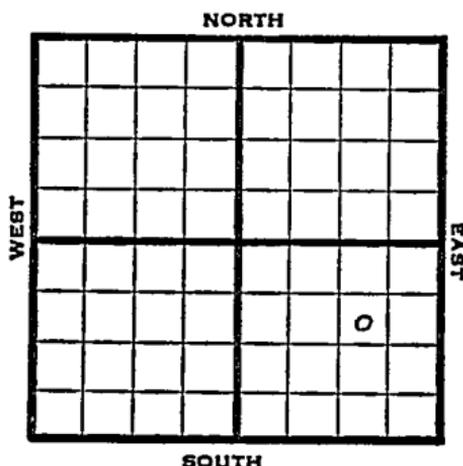

1951 Elev. 1841' REPORT

10/24 8' @ 662'
Drlg. 2255'

12/5 Oil Well TD 3288
8" @ 662
Heeb. 2888 1/2 or. 2906
Br. Li 2988 Lans. 3008
Cong. 3272 Arb. 3275
TD 3279
5" @ 3276 DD 3280 DD 3284
B/ 1 GOPH 200 A B/ 28 GO
3 GWPH DD 3288 B/ 24 BO
2 BW 24 hr.
Comp. 30 BOPD

COMPLETED

