


Section 15 Township 17 Range 11W

Well No. #8 Petermann SWD

Company Gulf Oil

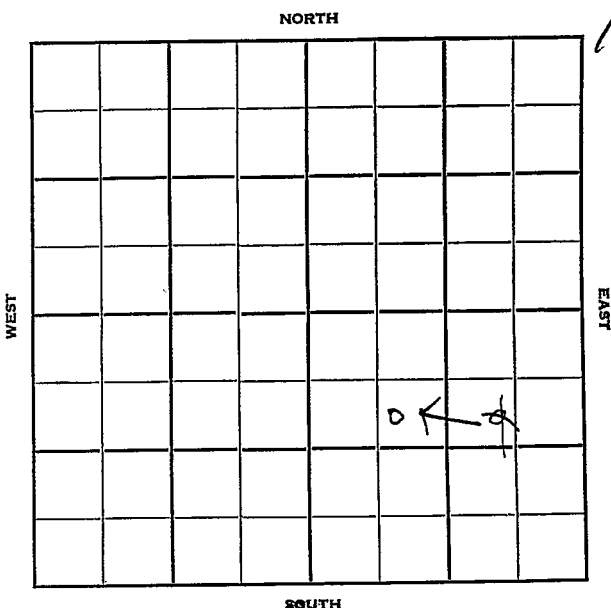

Barton

KANSAS

Sec. 15 - Twp. 17 R. 11W

Well No. #8 Petermann SWD Farm

Gulf Oil Company


Contractor

990 Ft. from N. Line

_____ Ft. from S. Line

~~805~~ Ft. from E. Line

805 Ft. from W. Line

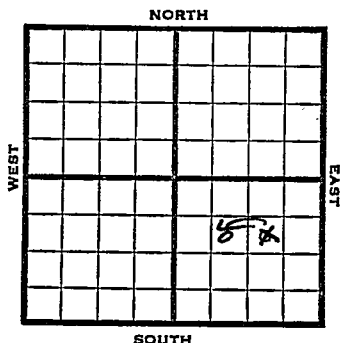

~~SE NW SE~~
~~SW NE SE~~

1951 Elev. 1831' REPORT

12/5 RUR

1952
1/9 Spud 12-3-51
SWD Well TD 3589
8" @ 218
Anhy 1755 Lans. 3008
Arb. 3258 Granite 3572
7" @ 3320
TD 3589
Comp. for SWD well

ABANDONED

County **Barton** State **Kansas**

Sec. **15** (Blk. **17** (Sur. **117** Map No.

Operator **GOLF 011**

Well No. 8 Farm Petermann SWD

Elev.	Location	SW	NE	SE
-------	----------	----	----	----

FIRST REPORT

990' Ft. From N Line SE

805 Ft. From E Line Quarter

1st. Report DEC 5 1951

Completion

Remarks

Spudding Date

Drlg. Data

R U R

J. E. TYRA

KANSAS

Map No. _____ Sec. 15 Twp. 17 R. 11WWell No. 8 Peterman SWDGulf Oil Company~~CORRECTION~~

Contractor

SE NW SE

SECTION PLAT

990 Ft. from N. Line

_____ Ft. from S. Line

_____ Ft. from E. Line

805 Ft. from W. Line

		0	

Barton County

Location _____

Rig up _____

Drilling and Remarks:

Reported

SW NE SE

RECORD

Cased _____ in., _____ ft.

Sand _____

Gas _____

Oil _____

Total Depth _____

PRODUCTION

1st 24 hrs. Nat. _____

1st 24 hrs. after shot _____

Gas _____ Cu. Ft.

Dry Hole _____

Abandoned _____


Date

DEC 1 2 1951

19

J. E. TYRA

Scout

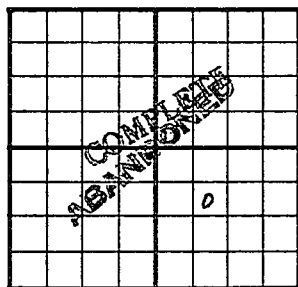County Barton State KansasSec. 15 (Blk.
Twp.) 17 (Sur.
Rge.) 11W Map No.Operator Gulf OilWell No. 8 Farm Petermann SWDElev. 1831 Location SE NW SE990 Ft. From N Line SE805 Ft. From W Line Quarter

1st. Report

Completion JAN 9 1952Remarks Kraft-Prusa PoolSpudding Date 12-3-51Drlg. Data SWD well TD 35898" @ 218 Anhy 1755 Lans. 3008Arb. 3258 Granite 3572 7" @ 3320TD 3589 Comp. for SWD well

J. E. TYRA