KANSAS


Form 51—5M—7-39—Palace

Barton

Section 16 Township 17 Range 11-W

Well No. #1 Barth

Company Hollow Drlg.

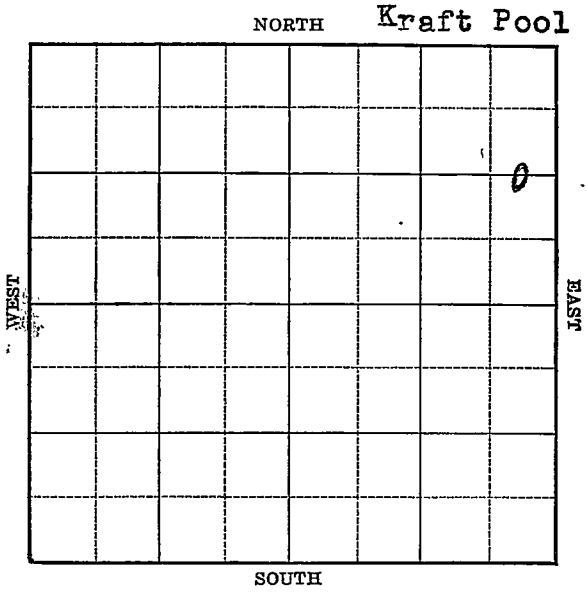

FORM 252-A 5M 2-40 KANSAS Barton

Sec. 16 Twp. 17 R. 11-W

Well No. #1 Barth Farm

Hollow Drlg. Company


(Kraft)

1320 Ft. from N. Line

Ft. from S. Line

330 Ft. from E. Line

Ft. from W. Line

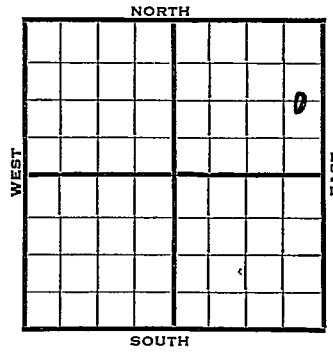

Elev. 1821

1940	REPORT
4/10	Bldg. Derrick.
4/18	10" - 284' ~~RXKYX~~ 657' Anhy.
	Drlg. 2310'
4/24	Arb. 3297'
	T.D. 3318'
	No shows.
	ABANDONED

Form 26—200 Bks.—1-40—Palace Barton KANSAS

Map No. 55 Sec. 16 Twp. 17 R. 11W

Well No. 1 Barthe

Hollow Drlg. Company

Contractor

FIRST REPORT

C E L NE

1320 Ft. from N. Line


Ft. from S. Line

330 Ft. from E. Line

Ft. from W. Line

Kraft Pool

SECTION PLAT

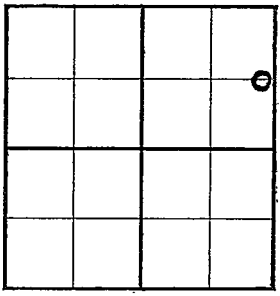

Location

Rig up

Drilling and Remarks:

Bldg, Derrick

RECORD

Cased in., ft.

Sand

Gas

Oil

Total Depth

PRODUCTION

1st 24 hrs. Nat.

1st 24 hrs. after shot

Gas Cu. Ft.

Dry Hole

Abandoned

Date

APR 10 1940 19

S. J. LEWIS Scout

Form 26—200 Bks.—1-40—Palace Barton KANSAS

Map No. 55 Sec. 16 Twp. 17 R. 11W

Well No. 1 Barth

Hollow Drilling Company

Contractor

ABANDONED

C E L NE

1320 Ft. from N. Line


Ft. from S. Line

330 Ft. from E. Line

Ft. from W. Line

KRAFT POOL

SECTION PLAT

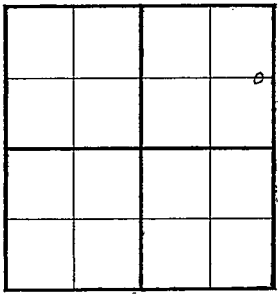

Location

Rig up

Drilling and Remarks:

Ar 3299

No shows

RECORD

Cased in., ft.

Sand

Gas

Oil

Total Depth 3318

PRODUCTION

1st 24 hrs. Nat.

1st 24 hrs. after shot

Gas Cu. Ft.

Dry Hole

Abandoned

Date

APR 2 1940 19

S. J. LEWIS Scout